

Leflore
P42
6-66

MISSISSIPPI BOARD OF WATER COMMISSIONERS

WATER WELL DRILLERS LOG

CODED

Date: 6/29, 1966, Driller: Butane Gas Co. County Leflore

(Name)

(1) Owner of Land: Ed Hunter Steele
(Name)

Morgan City, Miss.
(Address)

(2) Location: NE 1/4, NE 1/4, Sec. 10 T. 17 N. R. 1 W.
6 miles SE of Morgan City
(distance) (direction) (Nearest Town)

(3) Topography: (Hilly) (Flat) (Level)

(4) Purpose of Well: Irrigation
(Domestic Irrigation, Municipal, Industrial, Other)

Description & Color of Materials Sand, Clay, Red Clay, Shell, etc.	Thick- ness Feet	Depth Feet
Clay	13	13
Clay	10	23
Clay	10	33
Blue Clay	10	43
Blue Clay	10	53
Coarse Sand, Gravel	10	63
Coarse Sand, Gravel	10	73
Coarse Sand, Gravel	10	83
Coarse Sand, Gravel	10	93
Coarse Sand, Gravel	10	103
Coarse Sand, Gravel	10	113

Information upon completion of well:

(1) Diameter 12 inches.

(2) Total Depth 113 feet.

(3) Water Level 22 feet below top of ground.

(4) Cased to 73, Size 12

(5) Screen: Size 12, Length 40


(6) Were any formations sealed against pollution?
no yes, no.

If YES depth of formation _____

Why _____

Drillers Remarks: _____

CODED

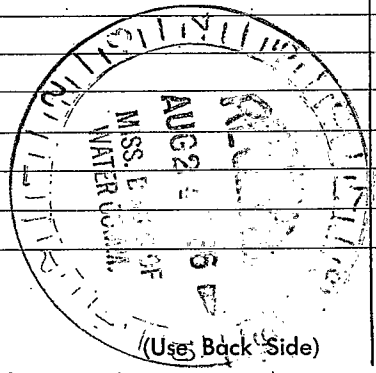

Well No.

