

Leflore
 P 44
 4-67

MISSISSIPPI
 BOARD OF WATER COMMISSIONERS
 416 North State Street
 Jackson, Mississippi 39201

WATER WELL DRILLERS LOG

CODED

4/12 1967 Dyer Well & Irrigation Leflore
 date well completed firm name county well located

LANDOWNER: Robert Morton
 Morgan City
 Miss. (mailing address)

description of formations encountered	from	to
Clay	0	33
Med. Sand	33	53
Coarse Sand	53	73
Coarse sand & gravel	73	93


WELL LOCATION:
 sec. 21 T. 17 N R. E
 S 2 W
 5 miles So of Morgan
 (distance) (direction) (nearest town)

WELL PURPOSE: Irrigation
 (home, irrigation, municipal, industrial)

WELL COMPLETION DATA:

- (1) diameter (inches) 16
- (2) total depth (feet) 93 Ft.
- (3) static water level (feet) 12 below above top of ground.
- (4) Blk. Iron casing 16" Pipe, 53 Ft., (material) (depth)
- (size) if telescope see back.
- (5) screen 40 Ft., 53 Ft. (length) (depth to top)
 16" Blk. Iron (Doerr) (size) (material)
- (6) pump 35 2,000 (HP) (yield gpm)
 Diesel (type power)
- (7) electric log No (yes or no)
 (organization running log)
- (8) how well bottom plugged Plate welded on bottom


CODED

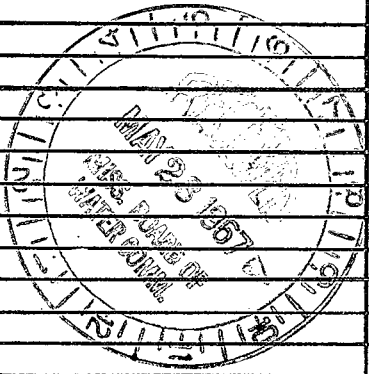

DRILLERS REMARKS:

If well telescopes please sketch and show depths.

GROUND LEVEL

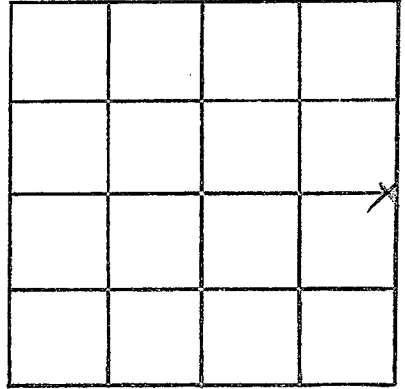

SECTION 2C

Please indicate well location X.

ADDITIONAL INFORMATION

If more than one screen, show locations of each on sketch.