

Leflore
P45
7-67

MISSISSIPPI
 BOARD OF WATER COMMISSIONERS
 416 North State Street
 Jackson, Mississippi 39201

WATER WELL DRILLERS LOG **CODED**

July 6 1967 Burda Co. of Greenwood Leflore
 date well completed film name county well located

LANDOWNER:
R. P. Aust
SWIFTOWN, Miss
 (mailing address)
 WELL LOCATION:
 sec. 29 T. 17 N. R. 2 E. S. W
IN miles (distance) of Swiftown (nearest town)


WELL PURPOSE: Home
 (home, irrigation, municipal, industrial)

- WELL COMPLETION DATA:
- (1) diameter (inches) 2"
 - (2) total depth (feet) 1406'
 - (3) static water level (feet) 15' above top of ground.
 - (4) casing Galv. (material), 1386' (depth),
2 (size) If telescope see back.
 - (5) screen 20ft (length), 1386 (depth to top),
2" (size), STAINLESS (material)
 - (6) pump NONE (HP), (yield gpm)
 (type power)
 - (7) electric log (yes or no)
 (organization running log)
 - (8) how well bottom plugged
Back Pressure Valve

description of formations encountered	from	to
Clay	0	6
Sand	6	86
Sand & Gravel	86	130
Clay	130	264
Sand	264	390
Gummy Shale	390	521
Hard Sand	521	733
Gummy Shale	733	824
Shale & Rocks	824	905
Green Sand	905	1115
Green Sandy Shale	1115	1346
Hard Sand	1346	1412
Gummy Shale	1412	1470

1470 T.D. Test Well


CODED

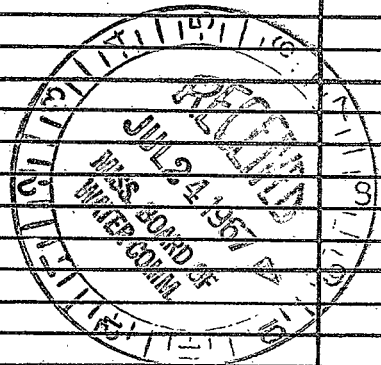

DRILLERS REMARKS:

If well telescopes please sketch and show depths.

GROUND LEVEL

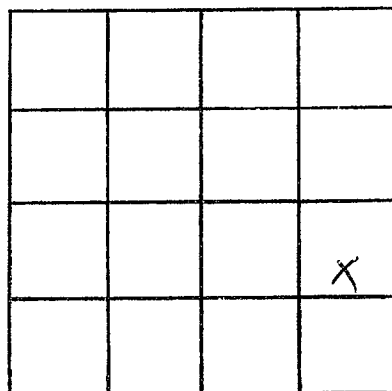

SECTION 29

Please indicate well location X.

ADDITIONAL INFORMATION

If more than one screen, show locations of each on sketch.