

LEFLORE
P 47
1-11-75

MISSISSIPPI
BOARD OF WATER COMMISSIONERS
416 North State Street
Jackson, Mississippi 39201

CODED

WATER WELL DRILLERS LOG

January 11, 1975 Dyer-Sullivan, Inc. Leflore
date well completed firm name county well located

LANDOWNER: E. D. Straub Jr. #1

description of formations encountered	from	to
Clay	0	33
Fine Sand	33	73
SAND + GRAVEL	73	113

Morgan City, Miss.

(mailing address)

WELL LOCATION:

sec. 30 T. 12 N. R. 2 E
5 miles S of Morgan City
(distance) (direction) (nearest town)

WELL PURPOSE: Irrigation
(home, irrigation, municipal, industrial):

WELL COMPLETION DATA:

- (1) diameter (inches) 12"
- (2) total depth (feet) 113
- (3) static water level (feet) 11 below above top of ground.
- (4) casing RIK Iron, 73
(material) (depth)
12" if telescope see back.
(size)
- (5) screen 40', 73'
(length) (depth to top)
16", RIK Inset
(size) (material)
- (6) pump 60, 3000
(HP) (yield gpm)
~~Electric~~ DIESEL
(type power)
- (7) electric log NO
(yes or no)
- (organization running log)
- (8) how well bottom plugged Plate

CODED


RECORDED
INDEXED
OCT 13 1975

DRILLERS REMARKS:

MISS. Bd. OF WATER COMMISSIONERS

If well telescopes please sketch and show depths.

GROUND LEVEL

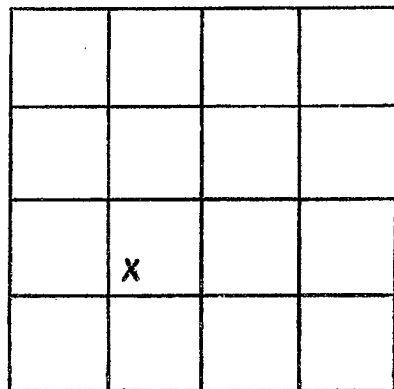

SECTION 30

Please indicate well location X.

ADDITIONAL INFORMATION

If more than one screen, show locations of each on sketch.