

LEFLORE
P 48
2-23-76

MISSISSIPPI
 BOARD OF WATER COMMISSIONERS
 416 North State Street
 Jackson, Mississippi 39201

CODED

WATER WELL DRILLERS LOG

2/23/76 19 BUTANE GAS CO. OF GREENWOOD Leflore
 date well completed firm name county well located

LANDOWNER:
S. A. Thompson
MORGAN City
 (mailing address)

description of formations encountered	from	to
<u>CLAY</u>	<u>0</u>	<u>40</u>
<u>SAND</u>	<u>40</u>	<u>50</u>
<u>SAND + GRAVEL</u>	<u>50</u>	<u>95</u>

WELL LOCATION:
 sec 3 T 17 N R 2 E
2 1/2 miles SW of Morgan City
 (distance) (direction) (nearest town)

CODED

WELL PURPOSE: IRR
 (home, irrigation, municipal, industrial)

WELL COMPLETION DATA:

(1) diameter (inches) 16"

(2) total depth (feet) 95

(3) static water level (feet) 16 below/above top of ground.

(4) casing Steel 55
 (material) (depth)
16" if telescope see back.
 (size)

(5) screen 40 55
 (length) (depth to top)
16" Steel
 (size) (material)

(6) pump 60 3000
 (HP) (yield gpm)
Diesel
 (type power)

(7) electric log No
 (yes or no)

(organization running log)

(8) how well bottom plugged Steel plate


DRILLER'S SIGNATURE
ALICE WATKINS

MAR 4 1976

DRILLERS REMARKS:

If well telescopes please sketch and show depths.

GROUND LEVEL

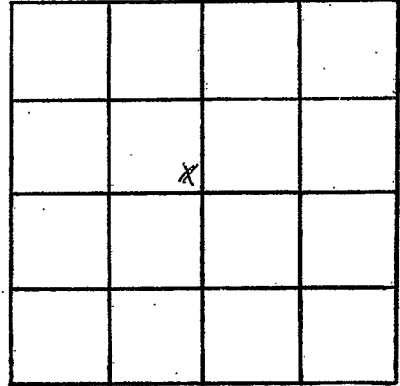

SECTION 3

Please indicate well location X.

ADDITIONAL INFORMATION

If more than one screen,
show locations of each on sketch.