

Leflore
P049
6-29-76

BOARD OF WATER COMMISSIONERS
416 North State Street
Jackson, Mississippi 39201

155

WATER WELL DRILLERS LOG

CODED

6-29
date well completed

1976

155
DYER-SULLIVAN, INC.
firm name

Leflore
county well located

LANDOWNER: E. D. STRAIN
MORGAN CITY, MISS.

(mailing address)

description of formations encountered	from	to
	CLAY	0
Fine SAND	23	39
Coarse SAND	39	56
Coarse SAND to GRAVEL	56	117
Rock	117	

WELL LOCATION:
sec. 35 T. 12 N. R. 2 E. W. W
6 miles S of MORGAN CITY
(distance) (direction) (nearest town)

CODED

WELL PURPOSE: IRRIGATION
(home, irrigation, municipal, industrial)

- WELL COMPLETION DATA:
- (1) diameter (inches) 16"
 - (2) total depth (feet) 117'
 - (3) static water level (feet) 14 below above top of ground.
 - (4) casing Steel, 77'
(material) (depth)
16"
(size) if telescope see back.
 - (5) screen 40' 77'
(length) (depth to top)
16", Steel
(size) (material)
 - (6) pump 60 2800
(HP) (yield gpm)
Diesel
(type power)
 - (7) electric log NO
(yes or no)

(organization running log)
 - (8) how well bottom plugged PLATE


RECEIVED
AUG 23 1976

DRILLERS REMARKS:

MISS. BD. OF WATER COMM.

If well telescopes please sketch and show depths.

GROUND LEVEL

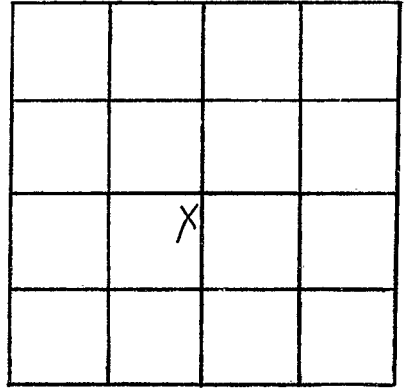

SECTION _____

Please indicate well location X.

ADDITIONAL INFORMATION

If more than one screen,
show locations of each on sketch.