

LEFLORE
P 50
4-7-78

MISSISSIPPI
BOARD OF WATER COMMISSIONERS
416 North State Street
Jackson, Mississippi 39201

CODED

WATER WELL DRILLERS LOG
BUTANE GAS COMPANY

4-7-78
date well completed 19

OF GREENWOOD

Leflore
county well located

LANDOWNER:
Wade Aust
Swiftown
(mailing address)

description of formations encountered	from	to
CLAY	0	42
SAND	42	50
SAND + Pea GRAVEL	50	98

WELL LOCATION:
sec. 22 T. 17 N. R. 2 E
8 W
1 miles NE of Swiftown
(distance) (direction) (nearest town)

WELL PURPOSE: FRR
(home, irrigation, municipal, industrial)

- WELL COMPLETION DATA:
- (1) diameter (inches) 16"
 - (2) total depth (feet) 98
 - (3) static water level (feet) 18 below above top of ground.
 - (4) casing Steel 58
(material) (depth)
16" if telescope see back.
(size)
 - (5) screen 40 58
(length) (depth to top)
16" Steel
(size) (material)
 - (6) pump 40 2000
(HP) (yield gpm)
Diesel
(type power)
 - (7) electric log No
(yes or no)
 - (organization running log)
 - (8) how well bottom plugged
Steel plate

CODED

RECEIVED


APR 21 1978

MISS. BD. OF WATER COMM

DRILLERS REMARKS:

If well telescopes please sketch and show depths.

GROUND LEVEL

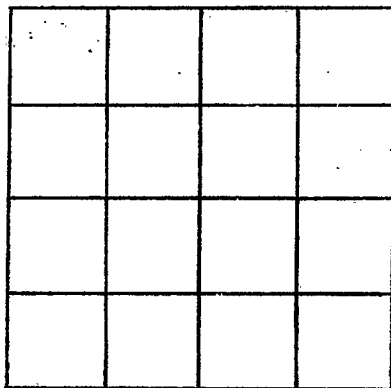

SECTION _____

Please indicate well location X.

ADDITIONAL INFORMATION

If more than one screen,
show locations of each on sketch.