

Leflore
 P-57
 10-4-79

MISSISSIPPI
 BOARD OF WATER COMMISSIONERS
 416 North State Street
 Jackson, Mississippi 39201

CODED

WATER WELL DRILLERS LOG

10/4 1979 DYER WELL #1RR LEFLORE
 date well completed firm name county well located

LANDOWNER:
 JOE LONG
 MORGAN CITY
 (mailing address)

description of formations encountered	from	to
CLAY	0	30
fine sand	30	38
sand	38	85
sand + gravel	85	98

WELL LOCATION:
 sec. 5 T. 17 N. R. 1 E
 S W
 3 miles SE of MORGAN CITY
 (distance) (direction) (nearest town)

WELL PURPOSE: IRRIGATION
 (home, irrigation, municipal, industrial)

- WELL COMPLETION DATA:
- (1) diameter (inches) 16
 - (2) total depth (feet) 98
 - (3) static water level (feet) 18 below top of ground.
 - (4) casing STEEL, 58' (material) (depth)
 16" if telescope see back. (size)
 - (5) screen 40, 58 (length) (depth to top)
 16, STEEL (size) (material)
 - (6) pump 60, 3000 (HP) (yield gpm)
 DIESEL (type power)
 - (7) electric log NO (yes or no)
 - (organization running log)
 - (8) how well bottom plugged PLATE

CODED

DEPT. OF NATURAL RESOURCES
 DIVISION OF LAND & WATER RESOURCES


JAN 16 1980

RECEIVED

DRILLERS REMARKS:

If well telescopes please sketch and show depths.

GROUND LEVEL

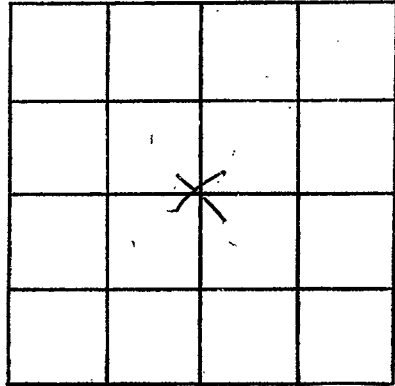

SECTION 5

Please indicate well location X.

ADDITIONAL INFORMATION

If more than one screen, show locations of each on sketch.