

LEFLORE
P-58
10-31-79

MISSISSIPPI
BOARD OF WATER COMMISSIONERS
416 North State Street
Jackson, Mississippi 39201

CODED

WATER WELL DRILLERS LOG

10/31 1979 DYER WELL LEFLORE
date well completed firm name county well located

LANDOWNER: SAM THOMPSON
BEN DOWNING
MORGAN CITY -
(mailing address)

description of formations encountered	from	to
Clay	0	28
Fine Sand	28	35
Sand	35	58
Sand & Gravel	58	113

WELL LOCATION:
sec. 10 T. 17 N R. 2 E
2 1/2 miles S of MORGAN CITY
(distance) (direction) (nearest town)

WELL PURPOSE:
(home, irrigation, municipal, industrial)

CODED

WELL COMPLETION DATA:
(1) diameter (inches) 16
(2) total depth (feet) 113
(3) static water level (feet) 20 below top of ground.
(4) casing STEEL 73 (material) (depth)
16 (size) if telescope see back.
(5) screen 40' 73 (length) (depth to top)
16 STEEL (size) (material)
(6) pump 60 3000 (HP) (yield gpm).
ELECTRIC (type power)
(7) electric log No (yes or no)
(organization running log)

(8) how well bottom plugged PLATE

DRILLERS REMARKS:


DEPT. OF NATURAL RESOURCES
BUREAU OF LAND & WATER RESOURCES

JAN 16 1980

RECEIVED

If well telescopes please sketch and show depths.

GROUND LEVEL

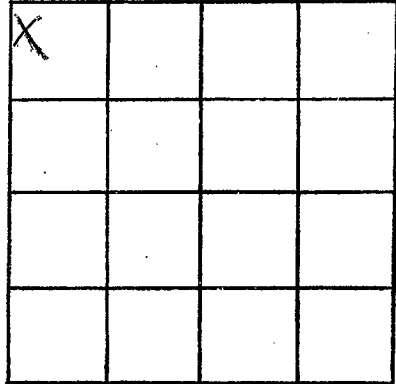

SECTION 10

Please indicate well location X.

ADDITIONAL INFORMATION

If more than one screen,
show locations of each on sketch.