

LEFLORE

#P-62

11-11-80

11-11-80

date well completed

MISSISSIPPI BOARD OF WATER COMMISSIONERS 416 North State Street Jackson, Mississippi 39201

CODED

WATER WELL DRILLERS LOG BUTANE GAS COMPANY

OF GREENWOOD

Leflore county well located

LANDOWNER:

Deerwood STRAIN

MORGAN City (mailing address)

WELL LOCATION:

sec. 6 T17N R1E of Morgan City (distance) (direction) (nearest town)

WELL PURPOSE: CAFEISH (home, irrigation, municipal, industrial)

WELL COMPLETION DATA:

- (1) diameter (inches) 16"
(2) total depth (feet) 108
(3) static water level (feet) 20 below top of ground.
(4) casing Steel 68 (material), (depth) 16" (size) If telescope see back.
(5) screen 40 68 (length), (depth to top) 16" (size), Steel (material)
(6) pump 40 (HP), 2600 (yield gpm)
(7) electric log (yes or no)
(8) how well bottom plugged Steel Plate

description of formations encountered

from to

Table with 3 columns: description of formations encountered, from, to. Rows include Clay, Sand, Sand + Pea Gravel, Fine Sand, Sand + Gravel, etc.


DRILLERS REMARKS:

DEPT. OF NATURAL RESOURCES BUREAU OF LAND & WATER RESOURCES

DEC - 8 1980 RECEIVED

If well telescopes please sketch and show depths.

GROUND LEVEL

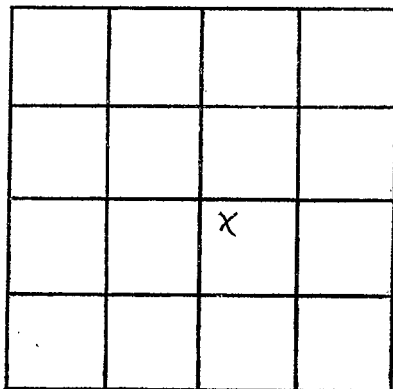

SECTION   /  

Please indicate well location X.

ADDITIONAL INFORMATION

If more than one screen,  
show locations of each on sketch.