

MISSISSIPPI DEPARTMENT OF NATURAL RESOURCES

Bureau of Land and Water Resources

Southport Mall

P.O. Box 10631

Jackson, Mississippi 39209 **CODED**

WATER WELL DRILLERS LOG

BUTANE GAS COMPANY Leflore

OF GREENWOOD

county well located

Leflore
P65
S-1-81

5-1-81 19
date well completed

LANDOWNER: Ben Downing
MORGAN City
(mailing address)

description of formations encountered	from	to
CLAY	0	35
SAND	35	40
SAND + Pea Gravel	40	60
SAND + GRAVEL	60	90


WELL LOCATION:
sec. 3 T. 17 N. R. 2 W.
2.5 miles S.W. of MORGAN City
(distance) (direction) (nearest town)

WELL PURPOSE: FAR
(home, irrigation, municipal, industrial)

- WELL COMPLETION DATA:
- (1) diameter (inches) 8"
 - (2) total depth (feet) 90
 - (3) static water level (feet) 25 below top of ground.
 - (4) casing Pvc 50,
(material) (depth)
6" If telescope see back.
(size)
 - (5) screen 40 90
(length) (depth to top)
8" Pvc
(size) (material)
 - (6) pump .10 450
(HP) (yield gpm)
Flec.
(type power)
 - (7) electric log NO
(yes or no)


(organization running log)
 - (8) how well bottom plugged Pvc CAP

DRILLERS REMARKS:

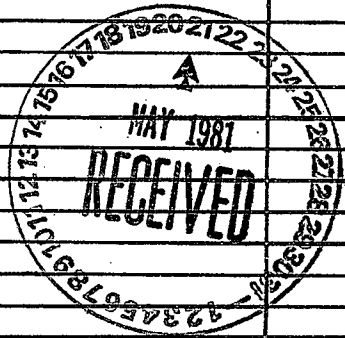

If well telescopes please sketch and show depths.

GROUND LEVEL

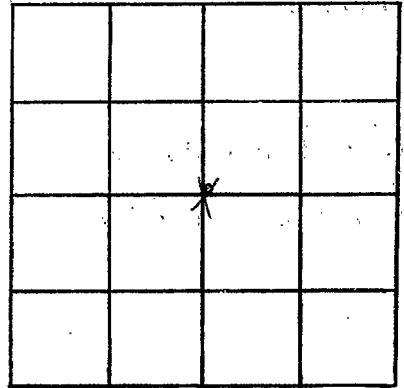

SECTION 3

Please indicate well location X.

ADDITIONAL INFORMATION

If more than one screen,
show locations of each on sketch.