

MISSISSIPPI DEPARTMENT OF NATURAL RESOURCES
Bureau of Land and Water Resources
 Southport Mall
 P.O. Box 10631
 Jackson, Mississippi 39209
WATER WELL DRILLERS LOG

CODED

Leflore
P 66
9/27/80

09/27 1980 Larry's Well & Pump Leflore
 date well completed firm name county well located

LANDOWNER: Black Bottom Farms
Inverness, MS.
 (mailing address)


description of formations encountered	from	to
<u>CLAY</u>	<u>0</u>	<u>35</u>
<u>FINE SAND</u>	<u>35</u>	<u>50</u>
<u>CORBE SAND & GRAVEL</u>	<u>50</u>	<u>110</u>

WELL LOCATION:
 sec. 14 T-17 N R-2 W
4 miles SW of MOBILE
 (distance) (direction) (nearest town)

WELL PURPOSE: Fish Pond
 (home, irrigation, municipal, industrial)


- WELL COMPLETION DATA:
- diameter (inches) 16"
 - total depth (feet) 110'
 - static water level (feet) 22 below above top of ground.
 - casing steel 70'
 (material) (depth)
 (size) if telescope see back.
 - screen 40' 70'
 (length) (depth to top)
16" steel
 (size) (material)
 - pump _____
 (HP) (yield gpm)
 (type power)
 - electric log No
 (yes or no)
 (organization running log)
 - how well bottom plugged steel plate

DRILLERS REMARKS: _____

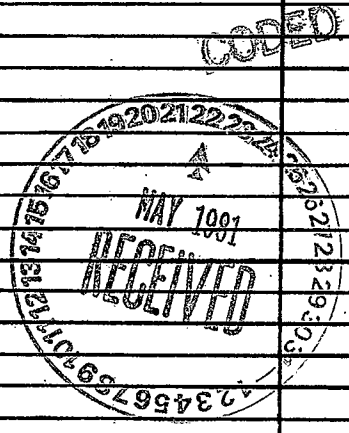

If well telescopes please
sketch and show depths.

GROUND LEVEL

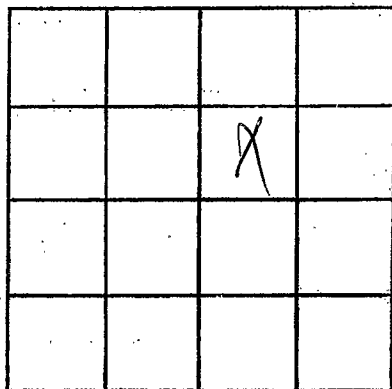

SECTION 124

Please indicate well location X.

ADDITIONAL INFORMATION

If more than one screen,
show locations of each on sketch.