

MISSISSIPPI DEPARTMENT OF NATURAL RESOURCES

Bureau of Land and Water Resources

Southport Mall

P.O. Box 10631

Jackson, Mississippi 39209


WATER WELL DRILLERS LOG

CODED

LeFlora
P 67
9/08/80


09/08 1980 date well completed Larry's well & Pump firm name Leflore county well located

LANDOWNER: <u>Black Bottom Farms</u>	description of formations encountered	from	to
Inverness MS (mailing address)			
WELL LOCATION: sec. <u>12 T 17 N</u> R. <u>2 E</u> <u>4</u> miles <u>S</u> of <u>Makani City</u> (distance) (direction) (nearest town)	<u>clay</u> <u>fine sand</u> <u>med sand</u> <u>course sand + gravel</u>	<u>0</u> <u>35</u> <u>40</u> <u>60</u>	<u>35</u> <u>40</u> <u>60</u> <u>108"</u>
WELL PURPOSE: <u>Fish Pond</u> (home, irrigation, municipal, industrial)			
WELL COMPLETION DATA:			
(1) diameter (inches) <u>16"</u>			
(2) total depth (feet) <u>108'</u>			
(3) static water level (feet) <u>17</u> below above top of ground.			
(4) casing <u>Steel</u> , <u>68'</u> (material) (depth)			
if telescope see back. (size)			
(5) screen <u>40'</u> , <u>68'</u> (length) (depth to top)			
<u>16"</u> , <u>Steel</u> (size) (material)			
(6) pump <u>60</u> , <u>3000</u> (HP) (yield gpm)			
<u>E. Vertus</u> (type power)			
(7) electric log <u>No</u> (yes or no)			
(organization running log)			
(8) how well bottom plugged <u>Steel Plate</u>			
DRILLERS REMARKS:			

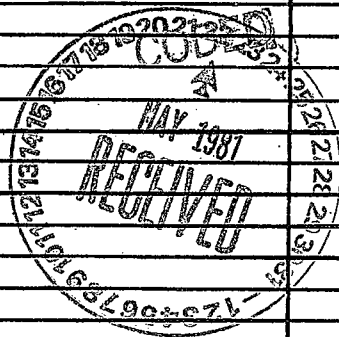

If well telescopes please sketch and show depths.

GROUND LEVEL

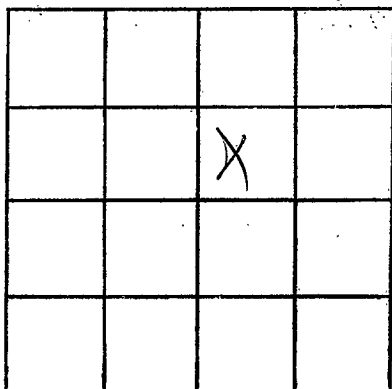

SECTION 12

Please indicate well location X.

ADDITIONAL INFORMATION

If more than one screen,
show locations of each on sketch.