


MISSISSIPPI DEPARTMENT OF NATURAL RESOURCES
 Bureau of Land and Water Resources
 Southport Mall
 P.O. Box 10631
 Jackson, Mississippi 39209
WATER WELL DRILLERS LOG

CODED

Leffone
 P68
 9/8/80

09/08 1980 date well completed
 Larry's Well & Pump firm name
 Leffone county well located


LANDOWNER: Black Bottom Farms	description of formations encountered	from	to
Inverness MS. (mailing address)			
WELL LOCATION: sec. 12 T. 17 N. R. 2 E. W. 4 (distance) miles (direction) of MOBILE CITY (nearest town)	fine sand	30	40
WELL PURPOSE: Fish Pond (home, irrigation, municipal, industrial)	med sand	40	60
WELL COMPLETION DATA: (1) diameter (inches) 16" (2) total depth (feet) 110' (3) static water level (feet) 17' below above top of ground. (4) casing steel, 70' (material) (depth) (size) if telescope see back. (5) screen 40' 70' (length) (depth to top) 16" steel (size) (material) (6) pump 60 3000 (HP) (yield gpm) (type power) (7) electric log NO (yes or no) (organization running log) (8) how well bottom plugged steel plate	coarse sand & gravel	60	110

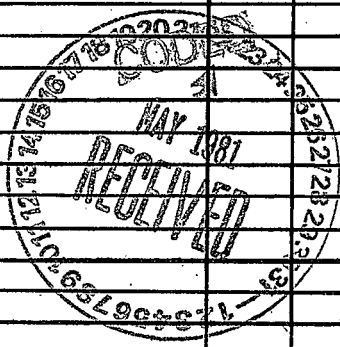

DRILLERS REMARKS:

If well telescopes please sketch and show depths.

GROUND LEVEL

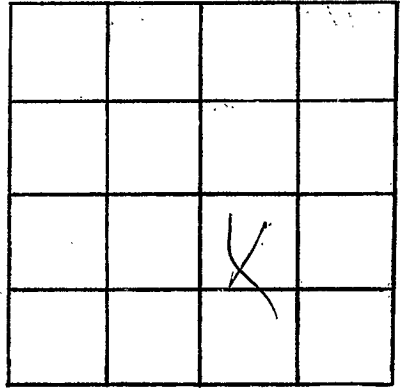

SECTION 22

Please indicate well location X.

ADDITIONAL INFORMATION

If more than one screen,
show locations of each on sketch.