

MISSISSIPPI DEPARTMENT OF NATURAL RESOURCES

Bureau of Land and Water Resources

Southport Mall

P.O. Box 10631

Jackson, Mississippi 39209

WATER WELL DRILLERS LOG

LeFlore
P 69
10/5/80


date well completed 10/05 1980 firm name Larry's well pump county well located LeFlore

LANDOWNER: <u>Black Bottom Farms</u>	description of formations encountered	from	to
<u>Inverness MS</u> (mailing address)	<u>CLAY</u> <u>FINE SAND</u> <u>CORSE SAND & GRAVEL</u>	<u>0</u> <u>40</u> <u>65</u>	<u>40</u> <u>65</u> <u>114</u>
WELL LOCATION: sec. <u>14</u> T <u>17</u> N R <u>2</u> W <u>4</u> miles <u>SW</u> of <u>Morgan city</u> (distance) (direction) (nearest town)			
WELL PURPOSE: <u>Fish Pond</u> (home, irrigation, municipal, industrial)			
WELL COMPLETION DATA:			
(1) diameter (inches) <u>16"</u>			
(2) total depth (feet) <u>114'</u>			
(3) static water level (feet) <u>22</u> below above top of ground.			
(4) casing <u>Steel</u> <u>74'</u> (material) (depth) (size) if telescope see back.			
(5) screen <u>40'</u> <u>74'</u> (length) (depth to top)			
<u>16"</u> <u>Steel</u> (size) (material)			
(6) pump <u>60</u> <u>3000</u> (HP) (yield gpm)			
(type power)			
(7) electric log <u>No</u> (yes or no)			
(organization running log)			
(8) how well bottom plugged <u>Steel Plate</u>			
DRILLERS REMARKS: _____ _____ _____			



If well telescopes please sketch and show depths.

GROUND LEVEL

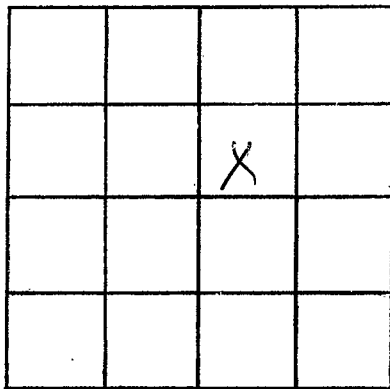

SECTION 14

Please indicate well location X.

ADDITIONAL INFORMATION

If more than one screen,
show locations of each on sketch.