

Bureau of Land and Water Resources

Southport Mall

P.O. Box 10631

Jackson, Mississippi 39209

WATER WELL DRILLERS LOG

0001
CODED

Leflore

VP 70

1-6-81

1/6/81

19

Pyle
firm name

Leflore
county well located

LANDOWNER:

BOBBY MORTON

Meridian City, MS
(mailing address)

description of formations encountered

from

to

Clay
sand
sand + gravel

0
175
25-103

WELL LOCATION:

sec. 1 T 170 N R 2 E
S W
miles Meridian City
(distance) (direction) (nearest town)


WELL PURPOSE:

(home, irrigation, municipal, industrial)


WELL COMPLETION DATA:

- (1) diameter (inches) 16"
- (2) total depth (feet) 103'
- (3) static water level (feet) 22' below above top of ground.
- (4) casing Steel 103'
(material) (depth)
- 16"
(size) If telescope see back.
- (5) screen 40' 63'
(length) (depth to top)
- 16" Steel
(size) (material)
- (6) pump 60 3000
(HP) (yield gpm)
- Electric
(type power)
- (7) electric log _____
(yes or no)
- _____ (organization running log)
- (8) how well bottom plugged plate

CODED

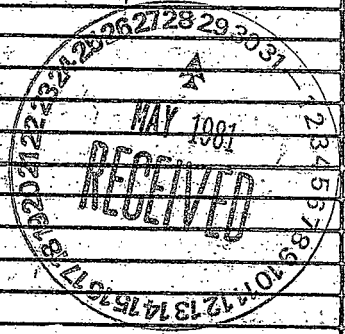

DRILLERS REMARKS:

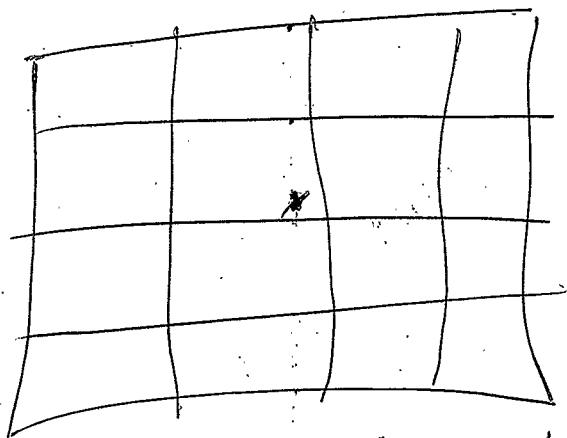

See 1