

MISSISSIPPI DEPARTMENT OF NATURAL RESOURCES

Bureau of Land and Water Resources

Southport Mall

P.O. Box 10631

CODED

Jackson, Mississippi 39209

WATER WELL DRILLERS LOG

Lefflore
PTI
1-1-81

01/01 1981 Larry's well & pump Lefflore
date well completed firm name county well located

LANDOWNER: <u>H.L. Castle</u>	description of formations encountered	from	to
<u>Belzoni, MS.</u> (mailing address)	<u>clay</u>	<u>0</u>	<u>40</u>
WELL LOCATION: sec. <u>21</u> T. <u>17</u> N. R. <u>20</u> E	<u>med sand</u>	<u>40</u>	<u>60</u>
<u>2</u> miles <u>NE</u> of <u>Smithtown</u> (distance) (direction) (nearest town)	<u>course sand & gravel</u>	<u>62</u>	<u>105</u>
WELL PURPOSE: <u>farm pond</u> (home, irrigation, municipal, industrial)			
WELL COMPLETION DATA:			
(1) diameter (inches) <u>8"</u>			
(2) total depth (feet) <u>100'</u>			
(3) static water level (feet) <u>17</u> <u>below</u> above top of ground.			
(4) casing <u>Plastic</u> , <u>60'</u> (material) (depth) (size) if telescope see back.			
(5) screen <u>40'</u> , <u>60'</u> (length) (depth to top) <u>8"</u> , <u>Plastic</u> (size) (material)			
(6) pump <u>10</u> <u>700</u> (HP) (yield gpm)			
<u>electric</u> (type power)			
(7) electric log <u>NO</u> (yes or no)			
(organization running log)			
(8) how well bottom plugged <u>PUC</u> <u>C&P</u>			
DRILLERS REMARKS:			

CODED


MISSISSIPPI DEPARTMENT OF NATURAL RESOURCES
BUREAU OF LAND & WATER RESOURCES

JUN 3 - 1981

RECEIVED

If well telescopes please sketch and show depths.

GROUND LEVEL

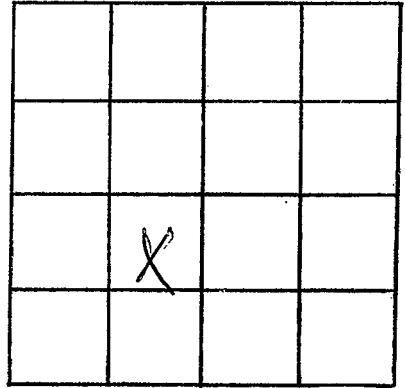

SECTION 21

Please indicate well location X.

ADDITIONAL INFORMATION

If more than one screen,
show locations of each on sketch.