

MISSISSIPPI DEPARTMENT OF NATURAL RESOURCES

Bureau of Land and Water Resources

Southport Mall

P.O. Box 10631

CODED

Jackson, Mississippi 39209

WATER WELL DRILLERS LOG

Lefflore
P72
5-2-81

date well completed May 02 1981 firm name Laramie Well & Pump county well located Lefflore

LANDOWNER: <u>Jimmy Lloyd</u>	description of formations encountered	from	to
<u>Morgan City</u> (mailing address)	<u>CLAY</u>	<u>0</u>	<u>30</u>
WELL LOCATION: sec. <u>25</u> T. <u>16</u> N. R. <u>2</u> E. W. <u>W</u>	<u>FINE SAND</u>	<u>30</u>	<u>50</u>
<u>6</u> miles <u>S</u> of <u>Morgan City</u> (distance) (direction) (nearest town)	<u>ME & CORSE</u>	<u>50</u>	<u>105</u>
WELL PURPOSE: <u>Fish Pond</u> (home, irrigation, municipal, industrial)			
WELL COMPLETION DATA:			
(1) diameter (inches) <u>12"</u>			
(2) total depth (feet) <u>105'</u>			
(3) static water level (feet) <u>21</u> below top of ground.			
(4) casing <u>Steel</u> , <u>65'</u> (material) (depth)	CODED		
(size) if telescope see back.			
(5) screen <u>40'</u> , <u>65'</u> (length) (depth to top)			
<u>12"</u> , <u>steel</u> (size) (material)			
(6) pump (HP) (yield gpm)			
(type power)			
(7) electric log <u>No</u> (yes or no)			
(organization running log)			
(8) how well bottom plugged <u>Steel Plate</u>			
DRILLERS REMARKS:			


DEPT. OF NATURAL RESOURCES
 BUREAU OF LAND & WATER RESOURCES

JUL 16 1981

RECEIVED

If well telescopes please sketch and show depths.

GROUND LEVEL

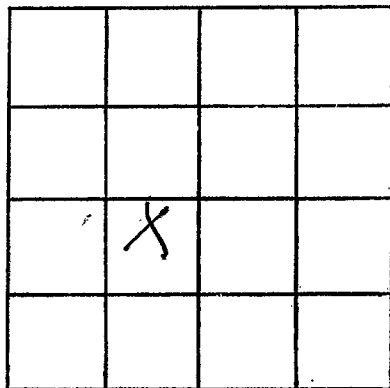

SECTION 25

Please indicate well location X.

ADDITIONAL INFORMATION

If more than one screen, show locations of each on sketch.