

MISSISSIPPI DEPARTMENT OF NATURAL RESOURCES

Bureau of Land and Water Resources

Southport Mall

P.O. Box 10631

Jackson, Mississippi 39209

WATER WELL DRILLERS LOG

CODED

Lefflore
P 73
5-2-81

May 02 1981 Lanning's Well & Pump Lefflore
 date well completed firm name county well located

LANDOWNER: Jimmy Lloyd
Morgan City
 (mailing address)

description of formations encountered	from	to
CLAY	0	45
FINE SAND	45	70
COURSE SAND	70	118

WELL LOCATION:
 sec. 25 T 16 N R 2 E
5 miles S of Morgan City
 (distance) (direction) (nearest town)

WELL PURPOSE: Fish Pond
 (home, irrigation, municipal, industrial)

- WELL COMPLETION DATA:
- (1) diameter (inches) 16"
 - (2) total depth (feet) 118'
 - (3) static water level (feet) 19 below above top of ground.
 - (4) casing steel, 78'
 (material) (depth)
 (size) if telescope see back.
 - (5) screen 40', 78'
 (length) (depth to top)
16", Steel
 (size) (material)
 - (6) pump 60, 3000
 (HP) (yield gpm)
 (type power)
 - (7) electric log NO
 (yes or no)
 (organization running log)
 - (8) how well bottom plugged Steel
Plate

CODED

DEPT. OF NATURAL RESOURCES
 BUREAU OF LAND & WATER RESOURCES


JUL 16 1981

RECEIVED

DRILLERS REMARKS:

If well telescopes please sketch and show depths.

GROUND LEVEL

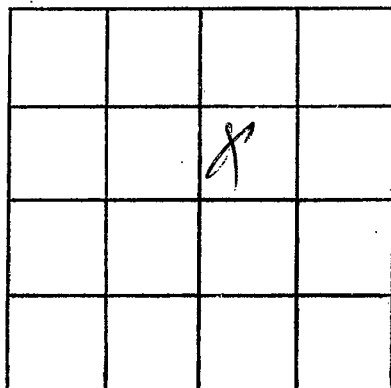

SECTION

25

Please indicate well location X.

ADDITIONAL INFORMATION

If more than one screen,
show locations of each on sketch.