

MISSISSIPPI DEPARTMENT OF NATURAL RESOURCES

Bureau of Land and Water Resources

Southport Mall

P.O. Box 10631

Jackson, Mississippi 39209

WATER WELL DRILLERS LOG

CODED

Leflore  
P 74  
6-30-81

date well completed

firm name

county well located

6/30/81 S. W. Myers & Sons Leflore

LANDOWNER:

Bobley Martin

description of formations encountered

from

to

Base

Morgan City MS 38916  
(mailing address)

Clay  
Sand  
Sand & Gravel

0 38  
38 55  
55 113

WELL LOCATION:

sec. 13 T 12 N S R 2 E W  
3 miles S of MORGAN CITY  
(distance) (direction) (nearest town)

WELL PURPOSE:

(home, irrigation, municipal, industrial)

CODED


WELL COMPLETION DATA:

- (1) diameter (inches) 16
- (2) total depth (feet) 113
- (3) static water level (feet) 20 below top of ground.
- (4) casing Steel (material) (depth)  
16 (size) if telescope see back.
- (5) screen 40 (length) (depth to top)  
16 (size) (material)
- (6) pump 14 (HP) 3000 (yield gpm)  
Diesel (type power)
- (7) electric log NO (yes or no)

(organization running log)


(8) how well bottom plugged Plate

DRILLERS REMARKS:

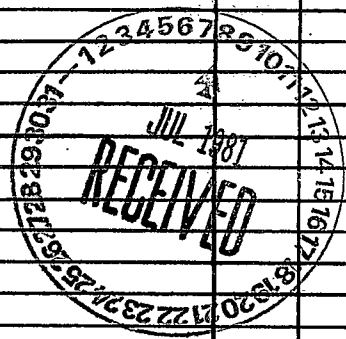

If well telescopes please sketch and show depths.

GROUND LEVEL

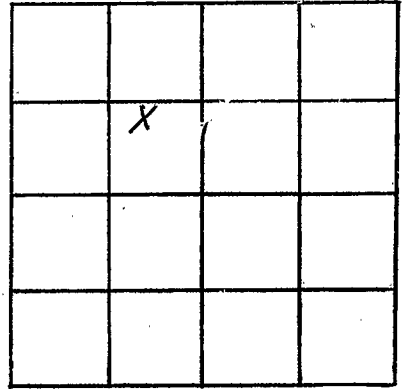

SECTION 13

Please indicate well location X.

ADDITIONAL INFORMATION

If more than one screen,  
show locations of each on sketch.