

MISSISSIPPI DEPARTMENT OF NATURAL RESOURCES

Bureau of Land and Water Resources

Southport Mall

P.O. Box 10631

BUTANE GAS CO. OF MISSISSIPPI 39209

POST OFFICE BOX 130 DRILLERS LOG

GREENWOOD, MISS. 38930

CODED


Lefflore  
P 76  
7-17-81  
July 17 1981  
date well completed

firm name

Lefflore  
county well located

LANDOWNER:	description of formations encountered	from	to
<u>Bobby Morton</u>			
<u>Morgan City</u> (mailing address)	<u>Sand &amp; gravel</u>	<u>40</u>	<u>125</u>
	<u>Clay</u>	<u>125</u>	<u>185</u>
	<u>Clay &amp; sand</u>	<u>185</u>	<u>620</u>
	<u>Clay</u>	<u>620</u>	<u>680</u>
	<u>Sand &amp; shale</u>	<u>680</u>	<u>1160</u>
	<u>Sand</u>	<u>1160</u>	<u>1240</u>
WELL LOCATION:			
sec. <u>1</u> T. <u>17</u> N. R. <u>2</u> E. S. <u>5</u> W.			
<u>1 1/2</u> miles (distance) <u>S</u> (direction) of <u>Morgan City</u> (nearest town)			
WELL PURPOSE: <u>Domestic</u> (home, irrigation, municipal, industrial)			
WELL COMPLETION DATA:			
(1) diameter (inches) <u>4" x 2"</u>			
(2) total depth (feet) <u>1229</u>			
(3) static water level (feet) <u>20</u> below top of ground.			
(4) casing <u>4" x 2"</u> , <u>1190</u> , (material) (depth)			
<u>4" x 2"</u> if telescope see back. (size)			
(5) screen <u>30'</u> , <u>1197</u> (length) (depth to top)			
<u>2"</u> , <u>stainless steel</u> (size) (material)			
(6) pump <u>3/4</u> , <u>10</u> (HP) (yield gpm)			
<u>electric</u> (type power)			
(7) electric log (yes or no) _____			
(organization running log) _____			
(8) how well bottom plugged <u>back wash valve</u>			

CODED

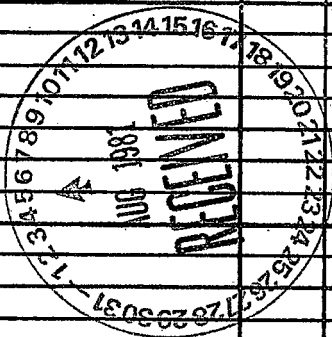

DRILLERS REMARKS:

D.L.

If well telescopes please sketch and show depths.

GROUND LEVEL



SECTION 1

Please indicate well location X.

ADDITIONAL INFORMATION

If more than one screen,  
show locations of each on sketch.