

MISSISSIPPI DEPARTMENT OF NATURAL RESOURCES

Bureau of Land and Water Resources

Southport Mall

P.O. Box 10631

Jackson, Mississippi 39209

WATER WELL DRILLERS LOG

CODED.

Leflore
P 78
7-17-81

date well completed July 17 1981 Larangi well & pump firm name Leflore county well located


LANDOWNER: <u>Mac Abernathy</u>	description of formations encountered	from	to
<u>Itta Bena, Ms</u> (mailing address)	<u>CLAY</u> <u>FINE SAND</u> <u>COURSE SAND</u>	<u>0</u> <u>50</u> <u>70</u>	<u>50</u> <u>70</u> <u>113</u>
WELL LOCATION: sec. <u>15</u> T. <u>17</u> N. R. <u>2</u> W <u>4</u> miles <u>SW</u> of <u>Morgan</u> (distance) (direction) (nearest town)			
WELL PURPOSE: <u>Fish Pond</u> (home, irrigation, municipal, industrial)			
WELL COMPLETION DATA:			
(1) diameter (inches) <u>16"</u>			
(2) total depth (feet) <u>113'</u>			
(3) static water level (feet) <u>24</u> below top of ground.			
(4) casing <u>Steel</u> , <u>93'</u> (material) (depth)			
(size) if telescope see back.			
(5) screen <u>40'</u> , <u>93'</u> (length) (depth to top)			
(6) pump <u>100</u> , <u>Steel</u> (size) (material)			
(6) pump <u>60</u> , <u>3000</u> (HP) (yield gpm)			
(type power)			
(7) electric log <u>NO</u> (yes or no)			
(organization running log)			
(8) how well bottom plugged <u>Steel Plate</u>			
DRILLERS REMARKS:			

CODED.

DEPT. OF NATURAL RESOURCES
BUREAU OF LAND & WATER RESOURCES
OCT 19 1981
RECEIVED

If well telescopes please sketch and show depths.

GROUND LEVEL

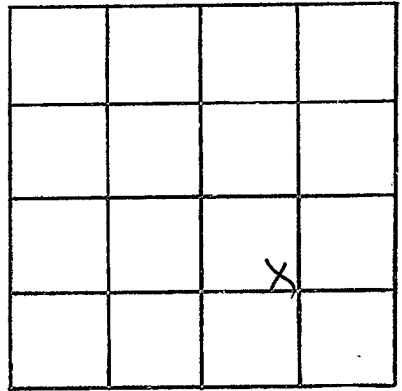

SECTION 15

Please indicate well location X.

ADDITIONAL INFORMATION

If more than one screen,
show locations of each on sketch.