

MISSISSIPPI DEPARTMENT OF NATURAL RESOURCES

Bureau of Land and Water Resources

Southport Mall

P.O. Box 10631

Jackson, Mississippi 39209

WATER WELL DRILLERS LOG

CODED

WLFLORE  
P80  
3-10-82  
Elog#107

March 10 19 82  
date well completed

Bruce Berryman  
firm name  
Greenwood.

Leflore

county well located

LANDOWNER: Charles Coker  
Rt. 2. Box 98  
Belzoni. MS 39038  
(mailing address)

WELL LOCATION:  
sec. 29 T. 17 N R. E  
S W  
5 miles SE of Morgan  
(distance) (direction) (nearest town)  
City

WELL PURPOSE: HOME  
(home, irrigation, municipal, industrial)

WELL COMPLETION DATA:

- (1) diameter (inches) 4" x 2"
- (2) total depth (feet) 1215'
- (3) static water level (feet) Flow below top of ground. blk - 126'
- (4) casing 2" galv. - 1069  
(material) (depth)  
If telescope see back.  
(size)
- (5) screen 20' 1195  
(length) (depth to top)  
2" .010 Stainless steel  
(size) (material)
- (6) pump 1 1/2 35  
(HP) (yield gpm)  
Electric  
(type power)
- (7) electric log YES  
(yes or no)

MS Dept. of Nat. Resources  
(organization running log)

B.P.V.

- (8) how well bottom plugged

DRILLERS REMARKS:

description of formations encountered	from	to
Clay	0	40
Sand	40	60
Sand & Gravel	60	110
Clay	110	140
Shale	140	200
Sandy shale	200	240
Sand	240	260
Shale	260	380
Fine sand	380	420
Sand	420	480
Shale	480	540
Brown sand	540	560
Shale	560	700
Sandy shale & rocks	700	750
Sand	750	760
Shale	760	790
Sand	790	820
Shale	820	930
Sand	930	940
Shale & rock	940	1010
Sand	1010	1030
Shale	1030	1070
Sand	1070	1100
Shale	1100	1150
Sand	1150	1170
Shale	1170	1180
Sand	1180	1230


DEPT. OF NATURAL RESOURCES  
BUREAU OF LAND & WATER RESOURCES

APR 27 1982

RECEIVED

If well telescopes please sketch and show depths.

GROUND LEVEL

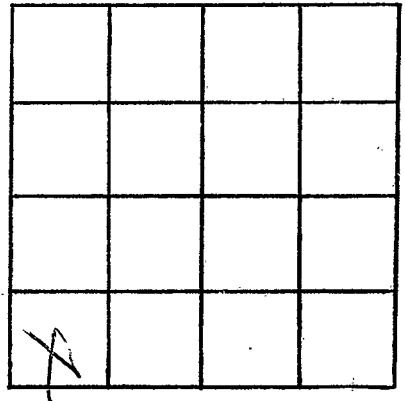

SECTION 29

Please indicate well location X.

ADDITIONAL INFORMATION

If more than one screen,  
show locations of each on sketch.