

MISSISSIPPI DEPARTMENT OF NATURAL RESOURCES

Bureau of Land and Water Resources

Southport Mall

P.O. Box 10631

Jackson, Mississippi 39209 CODED

WATER WELL DRILLERS LOG

LEFLORE  
P 81  
3183

19 date well completed

Dyer well  
firm name

Leflore  
county well located

LANDOWNER: Fred J. Ponder

description of formations encountered

from

to

(mailing address)

WELL LOCATION:

sec 28 T 17 N R 2 E  
S W  
3/4 miles NE of Swiftown  
(distance) (direction) (nearest town)

WELL PURPOSE:

(home, irrigation, municipal, industrial)

CODED

WELL COMPLETION DATA:

- (1) diameter (inches) 16
- (2) total depth (feet) 113
- (3) static water level (feet) 22 below above top of ground.
- (4) casing Steel 73' (material) (depth)
- (size) if telescope see back.
- (5) screen 40' (length) (depth to top)  
16" steel (size) (material)
- (6) pump 125 1800 (HP) (yield gpm)  
diesel (type power)
- (7) electric log no (yes or no)

(organization running log)

(8) how well bottom plugged plate

DRILLERS REMARKS:


DEPT. OF NATURAL RESOURCES  
BUREAU OF LAND & WATER RESOURCES

MAY 9 - 1993

RECEIVED

If well telescopes please sketch and show depths.

GROUND LEVEL

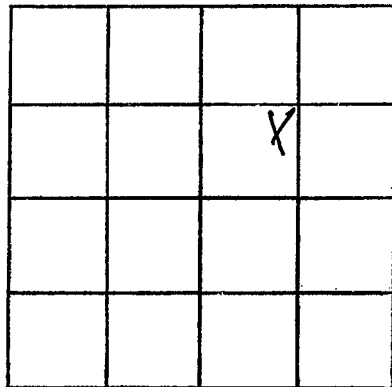

SECTION 28

Please indicate well location X.

ADDITIONAL INFORMATION

If more than one screen,  
show locations of each on sketch.