

LEFLORE  
P 82  
3/83

MISSISSIPPI DEPARTMENT OF NATURAL RESOURCES  
Bureau of Land and Water Resources  
Southport Mall  
P.O. Box 10631  
Jackson, Mississippi 39209  
WATER WELL DRILLERS LOG

CODED

date well completed 19 Dyer Well firm name Leflore county well located

LANDOWNER: Fred J. Boudry, Jr. description of formations encountered

	from	to
<u>Clay</u>	<u>0</u>	<u>48</u>
<u>Fine Sand</u>	<u>48</u>	<u>70</u>
<u>Sand + Gravel</u>	<u>70</u>	<u>113</u>

(mailing address)  
WELL LOCATION:  
sec. 28 T. 17 S. R. 2 E.  
1/2 miles NE of Swifttown  
(distance) (direction) (nearest town)

WELL PURPOSE:  
(home, irrigation, municipal, industrial)

WELL COMPLETION DATA:

- (1) diameter (inches) 16"
- (2) total depth (feet) 113
- (3) static water level (feet) 22 below above top of ground.
- (4) casing Steel, 73 (material) (depth)  
if telescope see back.
- (5) screen 40' (length) (depth to top)  
16" (size) steel (material)
- (6) pump 125 (HP) 1800 (yield gpm)  
diesel (type power)
- (7) electric log no (yes or no)  
(organization running log)
- (8) how well bottom plugged plate

CODED

DEPT. OF NATURAL RESOURCES  
BUREAU OF LAND & WATER RESOURCES


MAY 9 - 1983

RECEIVED

DRILLERS REMARKS:

If well telescopes please sketch and show depths.

GROUND LEVEL

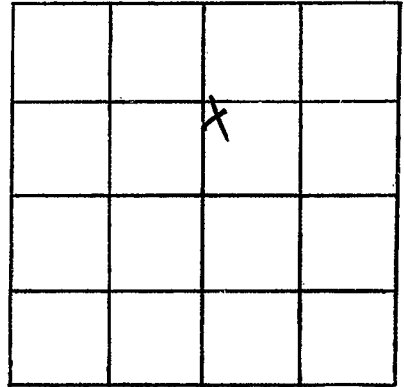

SECTION 28

Please indicate well location X.

ADDITIONAL INFORMATION

If more than one screen,  
show locations of each on sketch.