

DeFlora
P 83
7-9-79

MISSISSIPPI
 BOARD OF WATER COMMISSIONERS
 416 North State Street
 Jackson, Mississippi 39201

CODED

WATER WELL DRILLERS LOG
 BUTANE GAS COMPANY
 OF GREENWOOD

CODED

DeFlora
 county well located

7-9-79
 date well completed

LANDOWNER:
J. E. FONDREN
MORGAN CITY
 (mailing address)

description of formations encountered	from	to
Clay	0	30
Sand	30	45
Sand + Per Gravel	45	70
Sand + Gravel	70	110
Clay	110	124
Sand & Clay	124	180
Clay	180	250
Sandy Shale	250	390
Hard Shale	390	420
Sand	420	535
Sandy Shale	535	620
Gummy Shale	620	700
Shale Sand + Rock	700	840
Fine Sand + Shale	840	1010
Shale, Sand + Rock	1010	1150
Sand	1150	1180
Fine Sand + Shale	1180	1225
Sand	1225	1280
Shale	1280	1300

WELL LOCATION:
 sec. 1 T 17 N R. 1 E
1/2 miles S of MORGAN CITY
 (distance) (direction) (nearest town)

WELL PURPOSE: Home
 (home, irrigation, municipal, industrial)

- WELL COMPLETION DATA:
- (1) diameter (inches) 4 x 2
 - (2) total depth (feet) 1275
 - (3) static water level (feet) 40 ^{below} _{above} top of ground.
 - (4) casing Steel, 1245
 (material) (depth)
4 x 2 if telescope see back.
 (size)
 - (5) screen 30, 1245
 (length) (depth to top)
2", Stainless
 (size) (material)
 - (6) pump _____ 15 GPM
 (HP) (yield gpm)
 (type power)
 - (7) electric log _____
 (yes or no)
 (organization running log)
 - (8) how well bottom plugged
BACK PRESSURE VALVE

DRILLERS REMARKS:

Mississippi Board of Water Comm.

1111 11 1979

RECEIVED

If well telescopes please sketch and show depths.

GROUND LEVEL


105' - 4" CASING



7140' - 2" CASING



70' - 2" SCREEN

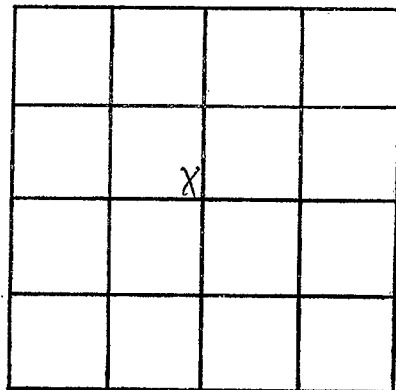

SECTION 1

Please indicate well location X.

ADDITIONAL INFORMATION

If more than one screen, show locations of each on sketch.