

Lefflore
P84

MISSISSIPPI DEPARTMENT OF NATURAL RESOURCES
Bureau of Land and Water Resources
Southport Mall
P.O. Box 10631
Jackson, Mississippi 39209
WATER WELL DRILLERS LOG

CODED

12-7
date well completed

1981 Over Well Irrigation
firm name

Lefflore
county well located

LANDOWNER: W. H. Morgan

description of formations encountered

from

to

Morgan City, Ms.
(mailing address)

CLAY 0-37
fine sand 37-40
SAND 40-100

WELL LOCATION:

sec. 6 T 17 N R 2 E
S 1 W
1 miles SE of MORGAN CITY
(distance) (direction) (nearest town)

WELL PURPOSE: Irrigation
(home, irrigation, municipal, industrial)

WELL COMPLETION DATA:

- (1) diameter (inches) 12"
- (2) total depth (feet) 100
- (3) static water level (feet) 13 below above top of ground.
- (4) casing steel, 60,
(material) (depth)
12 if telescope see back.
(size)
- (5) screen 40', 60
(length) (depth to top)
12,
(size) (material)
- (6) pump 40, 1500
(HP) (yield gpm)
- direct
(type power)
- (7) electric log No
(yes or no)
NONE
(organization running log)
- (8) how well bottom plugged Plate

DEPT. OF NATURAL RESOURCES
BUREAU OF LAND & WATER RESOURCES


MAY 14 1982

DRILLERS REMARKS:

RECEIVED

If well telescopes please sketch and show depths.

GROUND LEVEL

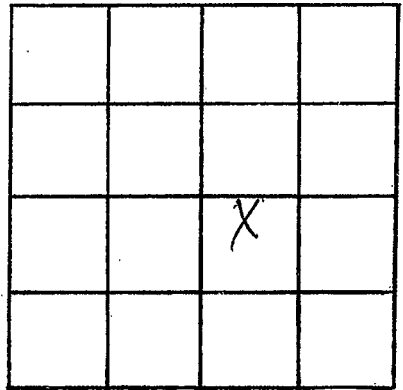

SECTION 6

Please indicate well location X.

ADDITIONAL INFORMATION

If more than one screen,
show locations of each on sketch.