

MISSISSIPPI DEPARTMENT OF NATURAL RESOURCES

Bureau of Land and Water Resources

Southport Mall

P.O. Box 10631

Jackson, Mississippi 39209

WATER WELL DRILLERS LOG

CODED

P 85
Leflore
8-1-83

8-1-

1983

Powell Irrigation Leflore

date well completed

firm name

county well located

LANDOWNER: Dunwood Strain
Itta Bena, Miss.
 (mailing address)

description of formations encountered	from to	
<u>CLAY</u>	<u>0</u>	<u>44</u>
<u>SAND</u> <u>Interval</u>	<u>44</u>	<u>113</u>

WELL LOCATION:
 sec 25 T. 17 N R. 2 E
4 miles south of Morgan City
 (distance) (direction) (nearest town)

CODED

WELL PURPOSE:
 (home, irrigation, municipal, industrial)

WELL COMPLETION DATA:

(1) diameter (inches) 16"

(2) total depth (feet) 113'

(3) static water level (feet) 28' below above top of ground.

(4) casing steel, 73'
 (material) (depth)
 (size) if telescope see back.

(5) screen 40', 73'
 (length) (depth to top)
16", steel
 (size) (material)

(6) pump 60, 3000
 (HP) (yield gpm)
electric
 (type power)

(7) electric log no
 (yes or no)

(organization running log)

(8) how well bottom plugged plate

DRILLERS REMARKS:


DEPT. OF NATURAL RESOURCES
BUREAU OF LAND & WATER RESOURCES

OCT 3 1983

RECEIVED

If well telescopes please sketch and show depths.

GROUND LEVEL

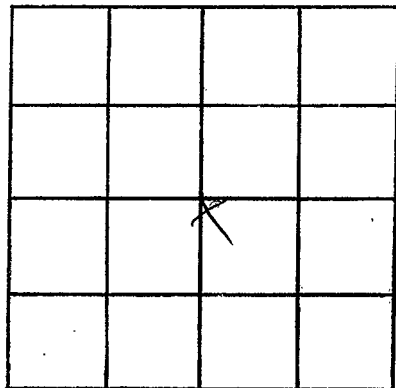

SECTION 25

Please indicate well location X.

ADDITIONAL INFORMATION

If more than one screen, show locations of each on sketch.