

MISSISSIPPI DEPARTMENT OF NATURAL RESOURCES

Bureau of Land and Water Resources

Southport Mall

P.O. Box 10631

Jackson, Mississippi 39209

WATER WELL DRILLERS LOG

CODED

P 86  
Leflore  
9-27-83

9-27  
date well completed

Lassy Well  
1983 Powell + Pump Service  
firm name

Leflore  
county well located

LANDOWNER:  
Bardin Redditt  
Sidon, Miss.  
(mailing address)

description of formations encountered	from to	
	feet	feet
Clay	0	14
Fine Sand	14	24
Sand + Gravel	24	103

WELL LOCATION:  
sec. 13 T. 17 N. R. 2 E  
4 miles E of Sidon  
(distance) (direction) (nearest town)

WELL PURPOSE:  
(home, irrigation, municipal, industrial)

- WELL COMPLETION DATA:
- (1) diameter (inches) 8"
  - (2) total depth (feet) 103'
  - (3) static water level (feet) 12' below top of ground.
  - (4) casing PUC, 63' (material) (depth)
  - (size) if telescope see back.
  - (5) screen 40' 63' (length) (depth to top)
  - 8" PUC (size) (material)
  - (6) pump 10 (HP) 240 (yield gpm)
  - electric (type power)
  - (7) electric log no (yes or no)

(organization running log)

(8) how well bottom plugged Cap

DRILLERS REMARKS:


DEPT. OF NATURAL RESOURCES  
BUREAU OF LAND & WATER RESOURCES

OCT 3 1983

RECEIVED

If well telescopes please sketch and show depths.

GROUND LEVEL

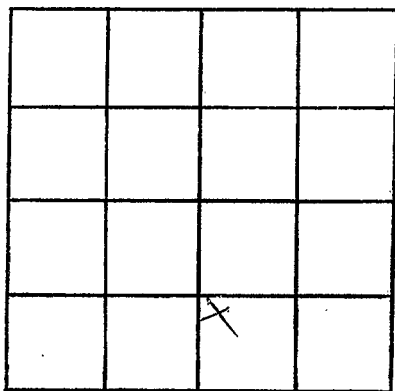

SECTION 4

Please indicate well location X.

ADDITIONAL INFORMATION

If more than one screen,  
show locations of each on sketch.