

MISSISSIPPI DEPARTMENT OF NATURAL RESOURCES

Bureau of Land and Water Resources

Southport Mall

P.O. Box 10631

Jackson, Mississippi 39299

WATER WELL DRILLERS LOG

CODED

Leflore

LEFLORE  
P 87

June 08 19 84  
date well completed

Larry's well's pump  
owner name

Humphreys Co.  
county well located

LANDOWNER: H. L. Castle

description of formations encountered

from

to

Belzoni, Mo.  
(mailing address)

log	0	30
Fine Sand	36	70
Coarse Sand	70	120

WELL LOCATION:

sec. 21 T 17 N R E  
S W  
2 miles N of Lefflore  
(distance) (direction) (nearest town)

CODED

WELL PURPOSE: FISH POND  
(home, irrigation, municipal, industrial)

WELL COMPLETION DATA:

- (1) diameter (inches) 8"
- (2) total depth (feet) 120'
- (3) static water level (feet) 22' below top of ground.
- (4) casing PVC, 80' (material) (depth)  
(size) if telescope see back.
- (5) screen 40' 80' (length) (depth to top)  
8" PVC (size) (material)
- (6) pump 20 1100 (HP) (yield gpm)  
Electric (type power)
- (7) electric log NO (yes or no)

(organization running log)

(8) how well bottom plugged PVC cap

DRILLERS REMARKS:


MISSISSIPPI DEPARTMENT OF NATURAL RESOURCES  
BUREAU OF LAND & WATER RESOURCES

OCT 24 1984

RECEIVED

If well telescopes please sketch and show depths.

GROUND LEVEL

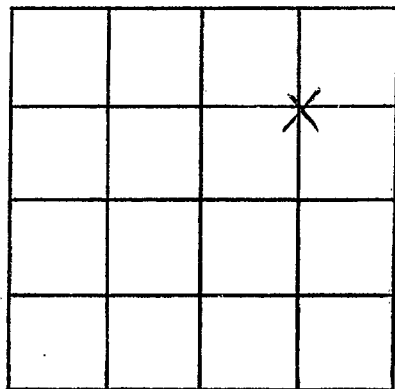

SECTION 21

Please indicate well location X.

ADDITIONAL INFORMATION

If more than one screen,  
show locations of each on sketch.