

MISSISSIPPI DEPARTMENT OF NATURAL RESOURCES

Bureau of Land and Water Resources

Southport Mall

P.O. Box 10631

CODED

Jackson, Mississippi 39209

WATER WELL DRILLERS LOG *Leflore Co.*

~~D46~~ P88
LEFLORE Co.
7-9-84

Date well completed July 09 1984 Larry's Well's pump firm name Humphreys Co. county well located

LANDOWNER: <u>Bud Rodgers</u>	description of formations encountered	from	to
<u>Belzoni, Ms</u> (mailing address)	<u>slay</u>	<u>0</u>	<u>20</u>
WELL LOCATION: sec <u>9</u> T <u>16</u> N S <u>5</u> R <u>2</u> E W <u>2</u>	<u>Fine Sand</u>	<u>20</u>	<u>70</u>
<u>4</u> miles <u>NE</u> of <u>Belzoni</u> (distance) (direction) (nearest town)	<u>course Sandstone</u>	<u>70</u>	<u>120</u>
WELL PURPOSE: (home, irrigation, municipal, industrial)	CODED		
WELL COMPLETION DATA:			
(1) diameter (inches) <u>16"</u>			
(2) total depth (feet) <u>150'</u>			
(3) static water level (feet) <u>12</u> ^{below} _{above} top of ground.			
(4) casing <u>Steel</u> , <u>80'</u> (material) (depth)			
(size) if telescope see back.			
(5) screen <u>40'</u> , <u>80'</u> (length) (depth to top)			
<u>16"</u> , <u>Steel</u> (size) (material)			
(6) pump <u>60</u> , <u>1200</u> (HP) (yield gpm)			
(type power)			
(7) electric log <u>NO</u> (yes or no)			
(organization running log)			
(8) how well bottom plugged <u>Steel Plate</u>			
DRILLERS REMARKS:	NOV 29 1984 RECEIVED		


DEPT. OF NATURAL RESOURCES
BUREAU OF LAND & WATER RESOURCES

NOV 29 1984

RECEIVED

If well telescopes please
sketch and show depths.

GROUND LEVEL

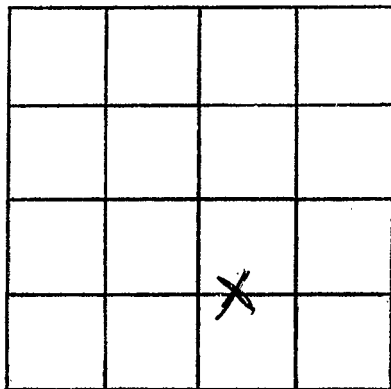

SECTION 9

Please indicate well location X.

ADDITIONAL INFORMATION

If more than one screen,
show locations of each on sketch.