

MISSISSIPPI DEPARTMENT OF NATURAL RESOURCES
Bureau of Land and Water Resources
 Southport Mall
 P.O. Box 10631
 Jackson, Mississippi 39209
WATER WELL DRILLERS LOG

CODED

P89
Leflore
6-15-84


6-15-84 date well completed Dyer well + Inc firm name Leflore county well located

LANDOWNER: <u>Larry J. Makana</u>	description of formations encountered	from	to
<u>Morgan City, Mo.</u> (mailing address)	<u>Clay</u> <u>Sand</u> <u>Sand & Gravel</u>	<u>0</u> <u>54</u> <u>58</u>	<u>54</u> <u>58</u> <u>98</u>
WELL LOCATION: sec. <u>2</u> T. <u>17</u> S. R. <u>2</u> E. <u>3</u> miles <u>South</u> of <u>Morgan City</u> (distance) (direction) (nearest town)			
WELL PURPOSE: (home, irrigation, municipal, industrial)			
WELL COMPLETION DATA:			
(1) diameter (inches) <u>12"</u>			
(2) total depth (feet) <u>98</u>			
(3) static water level (feet) <u>14</u> below above top of ground.			
(4) casing <u>Steel</u> , <u>58</u> , (material) (depth) <u>12"</u> if telescope see back. (size)			
(5) screen <u>40ft</u> , <u>58</u> (length) (depth to top) <u>12"</u> , <u>Steel</u> (size) (material)			
(6) pump <u>30</u> , <u>1200</u> (HP) (yield gpm) <u>Electric</u> (type power)			
(7) electric log <u>NO</u> (yes or no) <u>NO</u> (organization running log)			
(8) how well bottom plugged <u>Steel Plate</u>			
DRILLERS REMARKS:			

Handwritten notes:
 12-15-84
 J. J. [unclear]

If well telescopes please sketch and show depths.

GROUND LEVEL

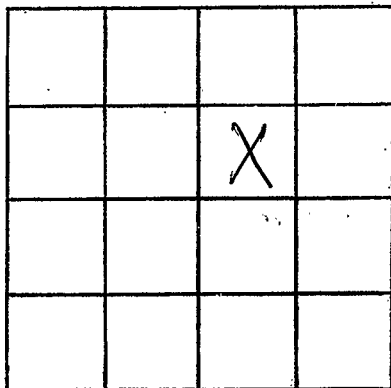

SECTION 2

Please indicate well location X.

ADDITIONAL INFORMATION

If more than one screen, show locations of each on sketch.