

MISSISSIPPI DEPARTMENT OF NATURAL RESOURCES

Bureau of Land and Water sources

Southport Mall

P.O. Box 10631

Jackson, Mississippi 39209

WATER WELL DRILLERS LOG

CODED

LEFLORE

P092

3-27-86

D30-86

March 27, 1986  
date well completed

DYER WELL, Inc.  
firm name

LEFLORE  
county well located

LANDOWNER: Earl J. Rindexter

description of formations encountered

from

to

Morgan City, Miss.  
(mailing address)

Clay	0	26
Full sand	26	65
Sand + gravel	65	108


WELL LOCATION:

sec. 20 T. 17 N. R. 2 E. S. W  
miles \_\_\_\_\_ of Swiftown  
(distance) (direction) (nearest town)

WELL PURPOSE: IRRIGATION  
(home, irrigation, municipal, industrial)

WELL COMPLETION DATA:

- (1) diameter (inches) 12 3/4
- (2) total depth (feet) 108
- (3) static water level (feet) \_\_\_\_\_ below above top of ground.
- (4) casing Steel (material), (depth) \_\_\_\_\_  
12 3/4 (size) if telescope see back.
- (5) screen 40' (length), 68 (depth to top)  
12 3/4 (size), Steel (material)
- (6) pump 30 (HP), 1500 (yield gpm)  
Diesel (type power)
- (7) electric log No (yes or no)  
(organization running log) \_\_\_\_\_
- (8) how well bottom plugged Plate

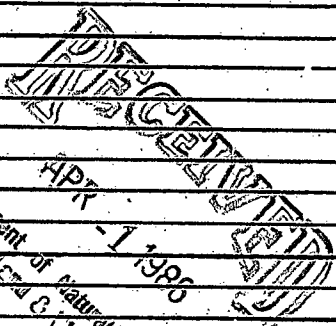

DRILLERS REMARKS:



