

MISSISSIPPI DEPARTMENT OF NATURAL RESOURCES

Bureau of Land and Water Resources

Southport Mall

P.O. Box 10631

Jackson, Mississippi 39209

WATER WELL DRILLERS LOG

LEFLORE
P 95

1-5 1987 J & K Irrigation LeFlore
 date well completed firm name county well located

LANDOWNER: Dow Shorts

description of formations encountered

from to

Free wood, Miss

TOP SOIL

0 9

CLAY

9 26

Fine SAND

26 49

COARSE SAND & GRAVEL

49 117

(mailing address)

WELL LOCATION:

sec. 1 T 17 N R 2 W
 1 miles SE of Morgantown
 (distance) (direction) (nearest town)

WELL PURPOSE: IRRIGATION
 (home, irrigation, municipal, industrial)

WELL COMPLETION DATA:

- (1) diameter (inches) 16
- (2) total depth (feet) 117
- (3) static water level (feet) 21 below top of ground.
- (4) casing Steel 77
 (material) (depth)
 16 if telescope see back.
 (size)
- (5) screen 40 77
 (length) (depth to top)
 16 Steel
 (size) (material)
- (6) pump 50 2400
 (HP) (yield gpm)
 Diesel
 (type power)
- (7) electric log NO
 (yes or no)

RECEIVED
 JAN 27 1987


Department of Natural Resources
 Bureau of Land & Water Resources

(organization running log)
 (8) how well bottom plugged Plate

DRILLERS REMARKS:

If well telescopes please sketch and show depths.

GROUND LEVEL

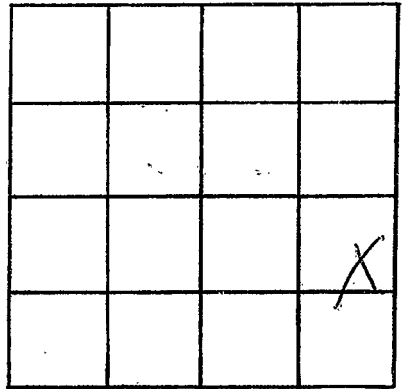

SECTION 1

Please indicate well location X.

ADDITIONAL INFORMATION

If more than one screen,
show locations of each on sketch.