

MISSISSIPPI DEPARTMENT OF NATURAL RESOURCES
Bureau of Land and Water Resources
 Southport Mall
 P.O. Box 10631
 Jackson, Mississippi 39209
WATER WELL DRILLERS LOG

LEFLORE
P 96

1-8 1987 J & K IRRIGATOR LeFlore
 date well completed firm name county well located

LANDOWNER: Floyd Melton
Greenwood, Miss

description of formations encountered	from	to
<u>TOP SOIL</u>	<u>0</u>	<u>6</u>
<u>CLAY</u>	<u>6</u>	<u>27</u>
<u>FINE SAND</u>	<u>27</u>	<u>38</u>
<u>COURSE SAND & GRAVEL</u>	<u>38</u>	<u>117</u>

(mailing address)

WELL LOCATION:
 sec. 1 T. 17 N. R. 2 W.
1 miles S of MOBILE
 (distance) (direction) (nearest town)

WELL PURPOSE: IRRIGATOR
 (home, irrigation, municipal, industrial)

WELL COMPLETION DATA:

- (1) diameter (inches) 16
- (2) total depth (feet) 117
- (3) static water level (feet) 22 ~~above~~ below top of ground.
- (4) casing Steel 77
 (material) (depth)
- 16 if telescope see back.
 (size)
- (5) screen 40 77
 (length) (depth to top)
- 16 Steel
 (size) (material)
- (6) pump 50 2400
 (HP) (yield gpm)
- Diesel
 (type power)
- (7) electric log NO
 (yes or no)

(organization running log)

(8) how well bottom plugged PIATE

RECEIVED


JAN 27 1987

Department of Natural Resources
 Bureau of Land & Water Resources

DRILLERS REMARKS:

If well telescopes please sketch and show depths.

GROUND LEVEL

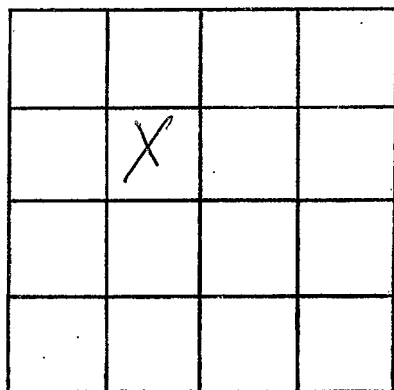

SECTION 1

Please indicate well location X.

ADDITIONAL INFORMATION

If more than one screen,
show locations of each on sketch.