

MISSISSIPPI DEPARTMENT OF NATURAL RESOURCES

Bureau of Land and Water Resources

Southport Mall

P.O. Box 10631

Jackson, Mississippi 39209

WATER WELL DRILLERS LOG

Top
Requested
LEFLORE
P 98

Coded
148c

10-13
date well completed

1987 *Dyer Well*
firm name

Leflore
county well located

LANDOWNER *Nick Chandler*
Box 95
Swiftown, Ms
(mailing address)

description of formations encountered	from	to
<i>CLAY</i>	<i>0</i>	<i>40</i>
<i>Sand & Gravel</i>	<i>40</i>	<i>108</i>

WELL LOCATION:
sec. *22* T. *17* N R. *2* W
2 miles *NE* of *Swiftown*
(distance) (direction) (nearest town)

WELL PURPOSE: *Irrigation*
(home, irrigation, municipal, industrial)

WELL COMPLETION DATA:

(1) diameter (inches) *16"*

(2) total depth (feet) *108'*

(3) static water level (feet) _____ below above top of ground.

(4) casing *steel* (material) _____ (depth) _____
16" (size) If telescope see back.

(5) screen *40'* (length) _____ (depth to top) _____
16" (size) _____ (material)

(6) pump _____ (HP) _____ (yield gpm)

(type power)

(7) electric log *No* (yes or no)
None (organization running log)

(8) how well bottom plugged *Plate*


RECEIVED
OCT 30 1987

Department of Natural Resources
Bureau of Land & Water Resources

DRILLERS REMARKS:

If well telescopes please
sketch and show depths.

GROUND LEVEL

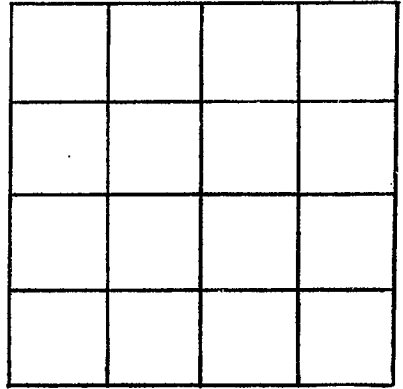

SECTION _____

Please indicate well location X.

ADDITIONAL INFORMATION

If more than one screen,
show locations of each on sketch.