

MISSISSIPPI DEPARTMENT OF NATURAL RESOURCES

Bureau of Land and Water Resources

COUNTY WELL LOCATED LeFlore	
WELL NUMBER P 100	CODED <input checked="" type="checkbox"/>
DATE WELL COMPLETED 12-8-87	

PERMIT NUMBER 8071
NAME OF DRILLING FIRM IRRIGATION Equipment
Indianola, MS 38751

P.O. Box 10631
Jackson, Mississippi 39209
WATER WELL DRILLERS LOG

NAME & MAILING ADDRESS OF LANDOWNER R. L. Maxwell			
P.O. Box 129			
INVERNESS, MS 38753			
WELL LOCATION:	SEC	TOWNSHIP	RANGE
	30	17	2
		N	E
		S	W
DISTANCE	DIRECTION	NEAREST TOWN	
2	West	of Swiftown	
OTHER LANDMARK			
WELL PURPOSE: Home, Irrigation, Municipal, Industrial, Fish Pond, etc. Pivot - Irrigation			

PUMP DATA		
PUMP TYPE (Circle One): Submersible, <u>Turbine</u> , Jet, Flowing Well, Other (Describe)		
POWER TYPE (Circle One): Electric, Tractor, <u>Diesel</u> , Gasoline, Butane, Other (Describe)		
Pump Capacity (GPM) 700	No. of Stages 3	Setting Depth 50 FT.
PUMP TEST		
Well yielded _____ GPM with a drawdown of _____ ft. after _____ hours of pumping		

WELL DATA		
Well Depth 105'	Casing Diameter (In.) 10	Casing Length (Ft.) 65'
Type of Casing PVC	Hole Depth 105'	Depth to Static Water Level 32'
TYPE OF COMPLETION: (Circle One or More): <u>Gravel Packed</u> , Underreamed, Telescoped, Natural Development, Open Hole, Other (Describe)		
Top of Lap Pipe or Reduction in Casing FEET IF TELESCOPED OR MORE THAN ONE SCREEN: USE BACK PAGE		

LOG DATA	
TYPE OF LOG RUN (Circle One): No Log Run, Electric, Gamma Ray, Density, Sonic, Neutron, Other (Describe)	
Name of Organization Running Log	

SCREEN DATA		
Diameter - Inches 10	Length - Feet 40	Slot Size - Inches .050
Screen Type PVC	Depth to Bottom - Feet 40	

GEOLOGIC DATA (Office Use Only)			
Surface Elev.	Geologic Unit	Unit Thickness	Depth to Top
Subs. SWL	Date	Analysis	Aquifer Test

Driller's Remarks Drilled for Big D Ink.
--


DESCRIPTION OF FORMATIONS ENCOUNTERED	FROM	TO	FORMATIONS (Continued)	FROM	TO
clay	0	10	RECEIVED DEC 22 1987 Department of Natural Resources Bureau of Land & Water Resources		
clay and sand	15	25			
coarse sand	25	35			
clay and sand	35	65			
coarse sand and gravel	65	105			

IF MORE SPACE IS NEEDED, USE BACK

If well telescopes please sketch and show depths.

GROUND LEVEL

IRRIGATION EQUIPMENT
601/887-2555
INDIANOLA, MS

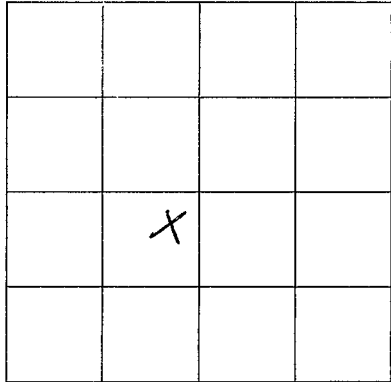

SECTION

30

Please indicate well location X.

ADDITIONAL INFORMATION

If more than one screen,
show location of each on sketch.