

MISSISSIPPI DEPARTMENT OF NATURAL RESOURCES

Bureau of Land and Water Resources

COUNTY WELL LOCATED LeFlore	
WELL NUMBER P 106	CODED
DATE WELL COMPLETED 4-10-89	

148C

PERMIT NUMBER
IRRI GATION EQUIPMENT
601/887-2555
INDIANOLA, MS

P.O. Box 10631
Jackson, Mississippi 39209
WATER WELL DRILLERS LOG

NAME & MAILING ADDRESS OF LANDOWNER		
T. A. Murtagh		
W. Washington		
MOORHEAD, MS		
WELL LOCATION:	SEC	TOWNSHIP
	17	17
		2
DISTANCE	DIRECTION	NEAREST TOWN
2 Miles	NORTH	of Swiftown
OTHER LANDMARK		
WELL PURPOSE: Home, Irrigation, Municipal, Industrial, Fish Pond, etc.		
IRRIGATION		

PUMP DATA		
PUMP TYPE (Circle One): Submersible, Turbine , Jet, Flowing Well, Other (Describe) _____		
POWER TYPE (Circle One): Electric, Tractor, Diesel , Gasoline, Butane, Other (Describe) _____ H/P 40		
Pump Capacity (GPM)	No. of Stages	Setting Depth
2000	2	50 FT.
PUMP TEST		
Well yielded _____ GPM with a drawdown of _____ ft. after _____ hours of pumping		

WELL DATA		
Well Depth 115'	Casing Diameter (In.) 12	Casing Length (Ft.) 75'
Type of Casing Steel	Hole Depth 115'	Depth to Static Water Level 21'
TYPE OF COMPLETION: (Circle One or More): Gravel Packed , Underreamed, Telescoped, Natural Development, Open Hole, Other (Describe) _____		
Top of Lap Pipe or Reduction in Casing		
FEET	IF TELESCOPED OR MORE THAN ONE SCREEN: USE BACK PAGE	

LOG DATA	
TYPE OF LOG RUN (Circle One): Electric, Gamma Ray, Density, Sonic, Neutron, Other (Describe) _____ No Log Run	
Name of Organization Running Log	

SCREEN DATA		
Diameter - Inches 12	Length - Feet 40	Slot Size - Inches .060
Screen Type Steel	Depth to Bottom - Feet 40	

GEOLOGIC DATA (Office Use Only)			
Surface Elev.	Geologic Unit	Unit Thickness	Depth to Top
Subs. SWL	Date	Analysis	Aquifer Test
Driller's Remarks			

DESCRIPTION OF FORMATIONS ENCOUNTERED	FROM	TO
clay	0	45
medium sand	45	55
COARSE SAND	55	85
Fine SAND	85	90
COARSE SAND	90	115

FORMATIONS CONTINUED	FROM	TO
APR 14 1989		
Department of Natural Resources Bureau of Land & Water Resources		

IF MORE SPACE IS NEEDED, USE BACK

If well telescopes please sketch and show depths.

IRRIGATION EQUIPMENT
601/887-2555
INDIANOLA, MS


GROUND LEVEL

			X

SECTION 17

Please indicate well location X.

ADDITIONAL INFORMATION

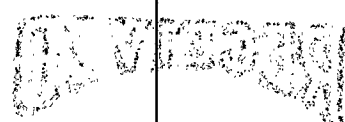

© 1987 by the Mississippi Department of
Agriculture, University of Mississippi

If more than one screen,
show location of each on sketch.