

MISSISSIPPI DEPARTMENT OF ENVIRONMENTAL QUALITY

Office of Land and Water Resources

P. O. Box 10631
Jackson, MS 39289-0631
WATER WELL DRILLERS LOG

COUNTY WELL LOCATED <u>LeFlore</u>	
WELL NUMBER <u>1P109</u>	CODED <input checked="" type="checkbox"/>
DATE WELL COMPLETED <u>10-95</u>	

PERMIT NUMBER
NAME OF DRILLING FIRM <u>CBS Drilling</u>

NAME & MAILING ADDRESS OF LANDOWNER <u>FITZ MORGAN</u>		
<u>RT. 3,</u>		
<u>Morgan City, ms</u>		
WELL LOCATION:	SEC	TOWNSHIP
<u>#</u>	<u>2</u>	<u>T19</u>
		RANGE
		<u>N R2</u>
		<u>E</u>
DISTANCE	DIRECTION	NEAREST TOWN
<u>4</u> Miles	<u>SW</u>	<u>Morgan City</u>
OTHER LANDMARK		
WELL PURPOSE: <input checked="" type="checkbox"/> Home Irrigation, <input type="checkbox"/> Municipal, <input type="checkbox"/> Industrial, <input type="checkbox"/> Fish Pond, etc.		

PUMP DATA		
PUMP TYPE (Circle One): <input checked="" type="checkbox"/> Submersible Turbine, Jet, Flowing Well, Other (Describe) _____		
POWER TYPE (Circle One): <input checked="" type="checkbox"/> Electric Tractor, Diesel, Gasoline, Butane, Other (Describe) _____ H/P _____		
Pump Capacity (GPM) <u>30</u>	No. of Stages <u>9</u>	Setting Depth <u>13</u> FT.
PUMP TEST		
Well yielded <u>30</u> GPM with a drawdown of _____ ft. after _____ hours of pumping		

WELL DATA		
Well Depth <u>1308</u>	Casing Diameter (In.) <u>4" x 2"</u>	Casing Length (Ft.) <u>1185</u>
Type of Casing <u>Steel</u>	Hole Depth <u>1325</u>	Depth to Static Water Level <u>Above</u>
TYPE OF COMPLETION: (Circle One or More): <input checked="" type="checkbox"/> Gravel Packed, <input type="checkbox"/> Underreamed, <input type="checkbox"/> Telescoped, <input checked="" type="checkbox"/> Natural Development, <input type="checkbox"/> Open Hole, <input type="checkbox"/> Other (Describe) _____		

LOG DATA	
TYPE OF LOG RUN (Circle One): Electric, Gamma Ray, Density, Sonic, Neutron, Other (Describe) _____ <input checked="" type="checkbox"/> No Log Run	
Name of Organization Running Log	

WELL GROUTED TO A DEPTH OF <u>10</u> FEET Type Grout (circle one): Cement, Bentonite, or Mix

GEOLOGIC DATA (Office Use Only)			
Surface Elev.	Geologic Unit	Unit Thickness	Depth to Top
Subs. SWL	Date	Analysis	Aquifer Test

SCREEN DATA		
Diameter - Inches <u>2"</u>	Length - Feet <u>30</u>	Slot Size - Inches <u>.010</u>
Screen Type <u>STAINLESS STEEL</u>	Depth to Bottom - Feet <u>1308</u>	


Driller's Remarks
DISCLAIMER

DESCRIPTION OF FORMATIONS ENCOUNTERED	FROM	TO	FORMAT IONS (Continued)	FROM	TO
<u>TOP SOIL to Clay</u>	<u>0</u>	<u>19</u>	FEB 05 1995 Dept. of Environmental Quality Office of Land & Water Resources		
<u>SAND</u>	<u>19</u>	<u>68</u>			
<u>SAND to FINE SAND</u>	<u>68</u>	<u>122</u>			
<u>SAND to CLAY</u>	<u>122</u>	<u>161</u>			
<u>SAND</u>	<u>161</u>	<u>342</u>			
<u>CLAY</u>	<u>342</u>	<u>425</u>			
<u>SAND to shale</u>	<u>425</u>	<u>482</u>			
<u>SAND</u>	<u>482</u>	<u>621</u>			
<u>Shale</u>	<u>621</u>	<u>1257</u>			
<u>SAND</u>	<u>1257</u>	<u>1312</u>			
<u>CLAY</u>	<u>1312</u>	<u>1335</u>			

IF MORE SPACE IS NEEDED, USE BACK

If well telescopes please sketch and show depths.

GROUND LEVEL

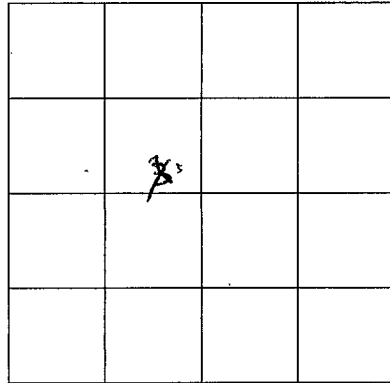

SECTION 3

Please indicate well location X.

ADDITIONAL INFORMATION

If more than one screen,
show location of each on sketch.