

P. O. Box 10631
Jackson, MS 39289-0631
WATER WELL DRILLERS LOG

COUNTY WELL LOCATED
LeFlore

WELL NUMBER: P-113 CODED

DATE WELL COMPLETED
6/22/01

PERMIT NUMBER

NAME OF DRILLING FIRM
Chicot Irrigation

NAME & MAILING ADDRESS OF LANDOWNER
W.P. Kim Brouge & Son
ITTA, Rena, Ms.

PUMP DATA

PUMP TYPE (Circle One):
Submersible, Turbine Jet Flowing Well,
Other (Describe)

POWER TYPE (Circle One):
Electric, Tractor, Diesel Gasoline, Butane,
Other (Describe) H/P 60

Pump Capacity (GPM) 1500 No. of Stages 2 Setting Depth 60 FT.

WELL LOCATION: SEC 15 TOWNSHIP 17 RANGE 10

DISTANCE 9 Miles DIRECTION South NEAREST TOWN ITTA BENE

OTHER LANDMARK
New Power Line

WELL PURPOSE: Home, Irrigation, Municipal, Industrial, Fish Pond, etc.

PUMP TEST
Well yielded _____ GPM with
a drawdown of _____ ft.
after _____ hours of pumping

WELL DATA

Well Depth 100 Casing Diameter (In.) 12 Casing Length (Ft.) 60

Type of Casing PVC Hole Depth 103 Depth to Static Water Level

TYPE OF COMPLETION: (Circle One or More):
Gravel Packed Underreamed, Telescoped,
Natural Development, Open Hole, Other
(Describe)

WELL GROUTED TO A DEPTH OF _____ FEET
Type Grout (circle one): Cement, Bentonite, or Mix

LOG DATA

TYPE OF LOG RUN (Circle One): No Log Run,
Electric, Gamma Ray, Density, Sonic, Neutron,
Other (Describe)

Name of Organization Running Log

GEOLOGIC DATA (Office Use Only)

Surface Elev.	Geologic Unit	Unit Thickness	Depth to Top
Subs. SWL	Date	Analysis	Aquifer Test

SCREEN DATA

Diameter - Inches 12 Length - Feet 40 Slot Size - Inches 051

Screen Type PVC Depth to Bottom - Feet 100

Driller's Remarks
33 18 48

090° 19 77

Top of Lap Pipe or Reduction in Casing
FEET IF TELESCOPED OR MORE THAN ONE SCREEN: USE BACK PAGE


DESCRIPTION OF FORMATIONS ENCOUNTERED	FROM	TO
<u>Top Soil</u>	<u>0</u>	<u>10</u>
<u>Gray CLAY</u>	<u>10</u>	<u>28</u>
<u>Blue Mud</u>	<u>28</u>	<u>50</u>
<u>Coarse Sand</u>	<u>50</u>	<u>70</u>
<u>Fine Sand</u>	<u>70</u>	<u>80</u>
<u>Coarse Sand.</u>	<u>80</u>	<u>100</u>

FORMATIONS (Continued)	FROM	TO
<u>ROCKS</u>	<u>100</u>	<u>103</u>

REC'D JUL 06 2001

If well telescopes please
sketch and show depths.

GROUND LEVEL

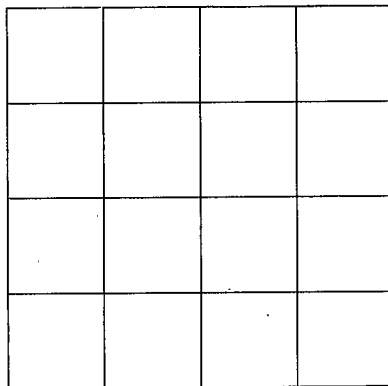

SECTION _____

Please indicate well location X.

ADDITIONAL INFORMATION

If more than one screen,
show location of each on sketch.