

MISSISSIPPI DEPARTMENT OF ENVIRONMENTAL QUALITY

Office of Land and Water Resources

P. O. Box 10631
Jackson, MS 39289-0631
WATER WELL DRILLERS LOG

COUNTY WELL LOCATED
Leflore

WELL NUMBER
P-116

CODED

DATE WELL COMPLETED
7-3-01

PERMIT NUMBER

NAME OF DRILLING FIRM
Chicot Irrigation

NAME & MAILING ADDRESS OF LANDOWNER
JOE COCKER FARMS
P.O. Box F
MORGAN CITY, MS 38942

WELL LOCATION: SEC _____ TOWNSHIP 29 17 RANGE 1

DISTANCE 16 MILES DIRECTION South NEAREST TOWN The Bera

OTHER LANDMARK
Levee - Yazoo River

WELL PURPOSE: Home Irrigation / Municipal, Industrial, Fish Pond, etc.

PUMP DATA

PUMP TYPE (Circle One):
Submersible, Turbine Jet Flowing Well,
Other (Describe) _____

POWER TYPE (Circle One):
Electric, Tractor, Diesel Gasoline, Butane,
Other (Describe) 40 H.P.

Pump Capacity (GPM) 1500 No. of Stages 2 Setting Depth 60 FT.

PUMP TEST

Well yielded _____ GPM with
a drawdown of _____ ft.
after _____ hours of pumping

WELL DATA

Well Depth 100 Casing Diameter (In.) 12 Casing Length (Ft.) 70

Type of Casing Pvc Hole Depth 103 Depth to Static Water Level _____

LOG DATA

TYPE OF LOG RUN (Circle One):
Electric, Gamma Ray, Density, Sonic, Neutron, Other (Describe) _____

Name of Organization Running Log

TYPE OF COMPLETION: (Circle One or More):
Gravel Packed Underreamed, Telescoped,
Natural Development, Open Hole, Other _____

WELL GROUTED TO A DEPTH OF _____ FEET
Type Grout (circle one): Cement, Bentonite, or Mix

GEOLOGIC DATA (Office Use Only)

Surface Elev.	Geologic Unit	Unit Thickness	Depth to Top
Subs. SWL	Date	Analysis	Aquifer Test

SCREEN DATA

Diameter - Inches 12 Length - Feet 30 Slot Size - Inches 051

Screen Type Pvc Depth to Bottom - Feet 100

Driller's Remarks
33 16 99
090 21 79

Top of Lap Pipe or Reduction in Casing _____ FEET

IF TELESCOPED OR MORE THAN ONE SCREEN: USE BACK PAGE


DESCRIPTION OF FORMATIONS ENCOUNTERED	FROM	TO
<u>Top Soil</u>	<u>0</u>	<u>10</u>
<u>Blue Mud</u>	<u>10</u>	<u>40</u>
<u>Fine Sand</u>	<u>40</u>	<u>70</u>
<u>Coarse Sand</u>	<u>70</u>	<u>100</u>
<u>Gravel</u>	<u>100</u>	<u>103</u>

FORMATIONS (Continued)	FROM	TO

REC'D SEP 07 2001

If well telescopes please
sketch and show depths.

GROUND LEVEL

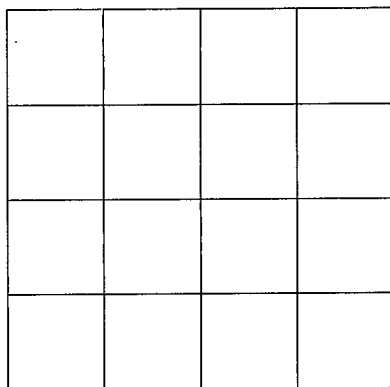

SECTION _____

Please indicate well location X.

ADDITIONAL INFORMATION

If more than one screen,
show location of each on sketch.