County:	Leflore 099	
Permit #: 6 w 39760 Irrigation equipment Driller:		
	ng completed: 8	-10-04

State Well Report

Part 1

Mississippi Department of Environmental Quality
Office of Land and Water Resources
P.O. Box 10631
Jackson, MS 39289-0631
(601)961-5210
(601)354-6938 (fax)

For Office Use Only:	
Aquifer:	
Well #: P-129	
L. S. Elevation:	
E-log #:	

State Law requires that this report be prepared by the driller in detail and filed with the Department within 30 days of completion of drilling of the well.

30 days of completion of drilling of the well.			
Well Owner Information	Well Location		
Owner Name Fitts Farms	Latitude:°" Longitude:°"		
Mailing Address: 10 Paul Fitts Lane	Method of Lat/Long (circle one): Conventional Survey,		
	USGS quad, Hand-held GPS, Survey-grade GPS		
Moorhead, MS 38761	NW 4 NW 4 Sec 18 Twn Rng 1W		
City State Zip Code			
Telephone No. ()	Distance Direction Nearest Town 3 Miles South of Morgan City		
Well I	Data		
Purpose of Well (circle one) Home Industrial Public Supply	rrigation Fish Culture Other:		
Date well drilling started: 8-10-04 Date w	well drilling completed: 8-10-04		
If flowing, method of flow regulation: Valve Other (d			
Static Water Level: 27ft. feet above or below (circle one) 1			
Method of Measurement (circle one) steel tape electric tape			
	Well grouted to a depth offeet		
	wen grouted to a ucput ofreet		
Type of grout (circle one): Cement Bentonite Mix			
Casing length: 75 feet Casing diameter: 16	<u> </u>		
Screen length: 40 feet Screen diameter: 16	inches Type of screen:PVC Sch. 40		
Screen slot size: 050 inches Setting depth: From	7.6feet_to115feet		
Type of completion (circle all applicable): Gravel packer Underreamed Telescoped Open hole Natural Development			
Other (describe):			
Top of lap pipe or reduction in casing:feet. If telescoped or more than one screen, describe on back of page			
Logs run (circle all applicable): No log run Electric Gamma Ray Density Sonic Neutron Other:			
Name of organization running log(s):			
I certify that the well was drilled, constructed, and completed in accordance with all applicable requirements of the Mississippi			
Department of Environmental Quality and/or the Mississippi Department of Health regulations and state laws.			
Irrigation Equipment Inc. Patrick M. Chism 0695 Patrick M. Chism 0695			
Print Name of Water Well Contractor and License No.	Signature of Water Well Contractor		

RECEIVED

AUG 1 6 2004


BY: OLWR

Ground	1 T	evel
OLUMBI		~~~

Description of Formations Encountered		To
Clay	0	40
Fine Sand	41	45
Fine Sand/gravel Med. Sand/gravel		50
Med. Sand/gravel	51	1115
		1
		1
		1
		+
		-
		+
	- 	+
		1
		1
		1
		1
	_	

If more than one screen, show location of each on sketch

Sketch the property layout and include the following: 1) the well location; 2) any permanent structures on the property that may aid in locating the well; 3) any roads, power lines, or other items that may aid in locating the property and the well; 4) indicate direction.

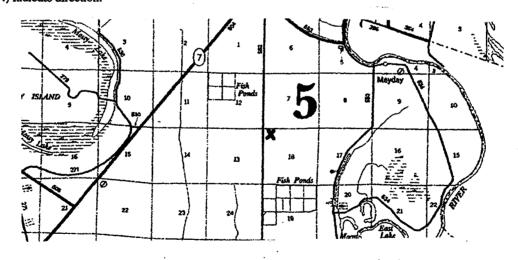

Fitts Farms

Landowner Name:

Patrick M Chisis

Signature of Water Well Contractor

STATE WELL REPORT

Part 2

County: Leflore

Permit #: \(\hat{\partial} \partial \text{39760} \)

Irrigation Equipment

Driller: \(\begin{arrigan} \text{8-11-04} \end{arrigan} \)

Pump Installer's Completion Report
Mississippi Department of Environmental Quality
Office of Land and Water Resources
P.O. Box 10631
Jackson, MS 39289-0631
(601)961-5210
(601)354-6938 (fax)

For Office Use Only:	
Aquifer:	
Well #:	
Elevation:	

This report should be prepared by the pump installer in deta installation of pump.	il and filed with the Department within 30 days of the	
Well Owner Information	Well Location	
Owner Name: Fitts Farms	Latitude:Longitude:	
Mailing Address: 10 Paul Fitts Lane	Method of Lat/Long (circle one): Conventional Survey,	
Moorhead, MS 38761 City State Zip Code 662-246-5081 Telephone No. ()	USGS quad, Hand-held GPS, Survey-grade GPS NW 1/4 NW 1/8 Sec 1 7N 1W Distance Direction Nearest Town 3 South Morgan City Miles of	
Pump Type Circle one	Power Type Circle one	
Air Lift Jet Submersible	Diesel Engine Gasoline Engine Natural Gas	
Bucket Piston Turbine	Electric Motor Hand Tractor PTO	
Centrifugal Rotary Flowing Well	Windmill Other (specify):	
Other (specify):	Horse Power Rating of Motor: 60	
Date Pump Installed: 8-11-04	Setting Depth: 70 feet	
Rated Pump Capacity: 2500-3000 Gallons Per Minute Number of Stages: 1		
Pump Test Data 8-11-04 Date Well Tested:	Method of Measuring Water Level Circle one	
Static Water Level (A): 27ft. Feet Below Land Surface	Air Line Electric Measuring Line steel Tape	
Pumping Water Level (B):Feet Below Land Surface	Other (specify):	
Drawdown [(B) - (A)]:Feet Below Land Surface	For flowing well, measured shut in head:feet	
Test Pumping Rate:Gallons Per Minute	Well yieldedGPM with a drawdown of	
Duration of Pump Test (minimum 4 hours):hours	feet afterhours of pumping	

Patrick M. Chism 0695

Print Name of Pump Installer and License No. (if applicable)

Signature of Pump Installer 2004

BY: OLWR