

MISSISSIPPI DEPARTMENT OF ENVIRONMENTAL QUALITY
Office of Land and Water Resources

P. O. Box 10631
Jackson, MS 39289-0631
WATER WELL DRILLERS LOG

COUNTY WELL LOCATED Leflore	
WELL NUMBER P 133	CODED
DATE WELL COMPLETED 4-30-04	

PERMIT NUMBER GW-39779
NAME OF DRILLING FIRM Irrigation Equipment Inc.
Indianola, MS

NAME & MAILING ADDRESS OF LANDOWNER Fitts Farms 10 Paul Fitts Lane Moorhead, MS 38761	
Latitude: Longitude:	
WELL LOCATION	SEC TOWNSHIP RANGE 8 17N S 1W E
DISTANCE	DIRECTION NEAREST TOWN 3 Miles SE Morgan City
OTHER LANDMARK	
WELL PURPOSE: Home, Irrigation, Municipal, Industrial, Fish Pond, etc. Irrigation	

WELL DATA

Well Depth 121	Casing Diameter (In.) 16	Casing Length (Ft.) 81
Type of Casing pvc	Hole Depth 121	Depth to Static Water Level 19ft.
TYPE OF COMPLETION: (Circle One or More): <input checked="" type="checkbox"/> Gravel Packed, <input type="checkbox"/> Underreamed, <input type="checkbox"/> Telescoped, <input type="checkbox"/> Natural Development, <input type="checkbox"/> Open Hole, <input type="checkbox"/> Other (Describe)		

WELL GROUTED TO A DEPTH OF **10** FEET
Type Grout (circle one): Cement, Bentonite, or Mix

SCREEN DATA

Diameter - Inches 16	Length - Feet 40	Slot Size - Inches .050
Screen Type pvc	Depth to Bottom - Feet 121	

PUMP DATA		
PUMP TYPE (Circle One): Submersible, <input checked="" type="checkbox"/> Turbine, Jet, Flowing Well, Other (Describe)		
POWER TYPE (Circle One): <input checked="" type="checkbox"/> Electric, Tractor, Diesel, Gasoline, Butane, Other (Describe) 60 H/P		
DESCRIPTION OF FORMATIONS ENCOUNTERED	FROM	TO
Clay	0	38
Fine Sand	39	45
Fine Sand/gravel	46	52
Med. Sand/gravel	53	121
RECEIVED		
AUG 30 2004		
YMD JOINT WATER MANAGEMENT DISTRICT		
Top of Lap Pipe or Reduction in Casing		
FEET	IF TELESCOPED OR MORE THAN ONE SCREEN: USE BACK PAGE	

I certify that the well was drilled, constructed and completed in accordance with all applicable Requirements of the Mississippi Department of Environmental Quality and/or the Mississippi Department of Health regulations and state laws.

[Signature] **0439**
Signature of Licensed Driller and License No.

5-14-04
Date


Additional Information Required On Back

*GW-39779
YMD*

DO NOT REMOVE ORIGINALS

If well telescopes please sketch and show depths.

GROUND LEVEL

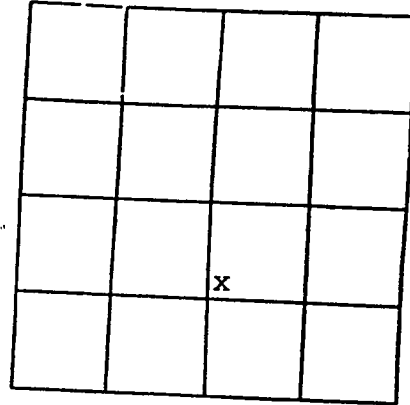

SECTION 8

Please indicate well location X.

Pump Capacity (GPM)	No. of Stages	Setting Depth
2500 to 3000	1	70 FT.

PUMP TEST

Well yielded _____ GPM with
a drawdown of _____ ft.
after _____ hours of pumping

LOG DATA

TYPE OF LOG RUN (Circle One): _____ No Log Run,
Electric, Gamma Ray, Density, Sonic, Neutron,
Other (Describe) _____

Name of Organization Running Log _____

GEOLOGIC DATA (Office Use Only)

Surface Elev.	Geologic Unit	Unit Thickness	Depth to Top
Subs. SWL	Date	Analysis	Aquifer Test

Driller's Remarks

If more than one screen,
show location of each on sketch.