

State Well Report

Part 1

Mississippi Department of Environmental Quality
Office of Land and Water Resources
P.O. Box 10631
Jackson, MS 39289-0631
(601)961-5210
(601)354-6938 (fax)

County: Leflore
 Permit #: 6W 40928
 Irrigation Equipment
 Driller: _____
 Date drilling completed: 3-16-06

For Office Use Only:

Aquifer: _____
 Well #: P-138
 L. S. Elevation: _____
 E-log #: _____

State Law requires that this report be prepared by the driller in detail and filed with the Department within 30 days of completion of drilling of the well.

Well Owner Information	Well Location
Owner Name: <u>W.H. Morgan</u>	Latitude: <u>33.21 49.7</u> ^N Longitude: <u>90.19 45.9</u> ^W
Mailing Address: <u>906 Weightman St.</u>	Method of Lat/Long (circle one): <u>49</u> Conventional Survey, <u>46</u>
<u>Greenwood MS 38930</u>	USGS quad, Hand-held GPS, Survey-grade GPS
City State Zip Code	<input checked="" type="checkbox"/> SE <input checked="" type="checkbox"/> SE <input type="checkbox"/> NW <input type="checkbox"/> SW
Telephone No. <u>662-453-5612</u>	<u>6</u> <u>5</u> <u>17</u> ^N <u>1</u> ^W
	Distance Direction Nearest Town
	<u>1</u> Miles <u>South</u> of <u>Morgan City</u>

Well Data

Purpose of Well (circle one) Home Industrial Public Supply Irrigation Fish Culture Other: _____

Date well drilling started: 3-16-06 Date well drilling completed: 3-16-06

If flowing, method of flow regulation: Valve _____ Other (describe) _____

Static Water Level: _____ feet above or below (circle one) land surface Date measured: _____

Method of Measurement (circle one) steel tape electric tape air line other: _____

Hole depth: 116 Well depth: 116 Well grouted to a depth of 10 feet

Type of grout (circle one): Cement Bentomite Mix

Casing length: 76 feet Casing diameter: 16 inches Type of casing: PVC SCH. 40

Screen length: 40 feet Screen diameter: 16 inches Type of screen: PVC Sch. 40

Screen slot size: .050 inches Setting depth: From 77 feet to 116 feet

Type of completion (circle all applicable): Gravel packed Underreamed Telescoped Open hole Natural Development

Other (describe): _____

Top of lap pipe or reduction in casing: _____ feet. If telescoped or more than one screen, describe on back of page

Logs run (circle all applicable) (No log run) Electric Gamma Ray Density Sonic Neutron Other: _____

Name of organization running log(s): _____

I certify that the well was drilled, constructed, and completed in accordance with all applicable requirements of the Mississippi Department of Environmental Quality and/or the Mississippi Department of Health regulations and state laws.

Irrigation Equipment Inc.
Patrick M. Chism 0695

Print Name of Water Well Contractor and License No. Signature of Water Well Contractor

Landowner contracted with Kelly Vest.
 Pump will be installed by Kelly Vest.

RECEIVED
 MAR 20 2006
 BY: OLWR

If well telescopes please sketch below and show depths.


P-

Ground Level

Description of Formations Encountered	From	To
Clay	0	40
Fine Sand/gravel	41	50
Med. Sand/gravel	51	116

If more than one screen, show location of each on sketch

Sketch the property layout and include the following: 1) the well location; 2) any permanent structures on the property that may aid in locating the well; 3) any roads, power lines, or other items that may aid in locating the property and the well; 4) indicate direction.

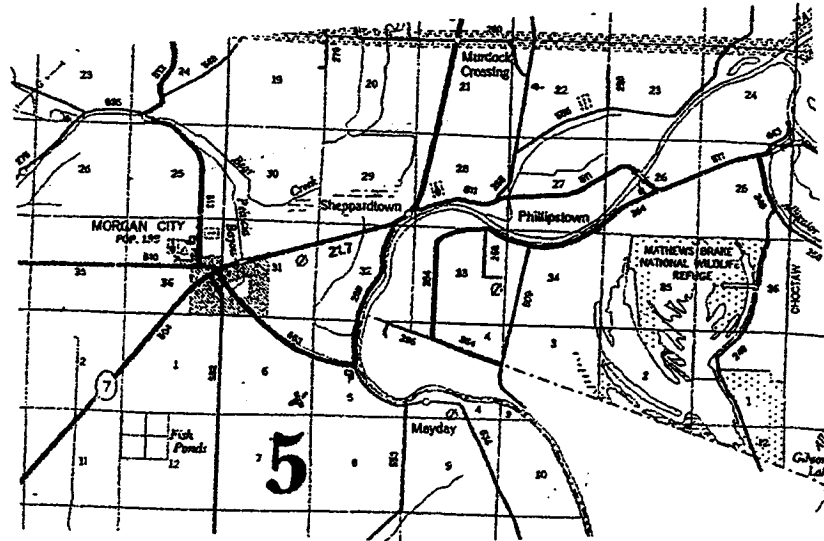

Landowner Name: _____

Patrick M. Chin

 Signature of Water Well Contractor

STATE WELL REPORT

Part 2

Pump Installer's Completion Report
 Mississippi Department of Environmental Quality
 Office of Land and Water Resources
 P.O. Box 10631
 Jackson, MS 39289-0631
 (601)961-5210
 (601)354-6938 (fax)

County: Leflore
 Permit #: GW40928
 Driller: _____
 Date completed: 3-17-06

For Office Use Only:

Aquifer: _____
 Well #: P-138
 Elevation: _____

This report should be prepared by the pump installer in detail and filed with the Department within 30 days of the installation of pump.

Well Owner Information	Well Location
Owner Name: <u>W.H. Morgan</u>	Latitude: _____ Longitude: _____
Mailing Address: <u>906 Weightman St.</u>	Method of Lat/Long (circle one): Conventional Survey, USGS quad, Hand-held GPS, Survey-grade GPS
<u>Greenwood, MS 38930</u> City State Zip Code	<u>1/4</u> <u>1/4</u> Sec <u>6</u> Twn <u>17N</u> Rng <u>1W</u>
Telephone No. (<u> </u>) <u>562-453-5612</u>	Distance Direction <u>5</u> Nearest Town <u>1</u> Miles <u>South</u> of <u>Morgan City</u>

Pump Type Circle one	Power Type Circle one
Air Lift Jet Submersible	<input checked="" type="radio"/> Diesel Engine Gasoline Engine Natural Gas
Bucket Piston <input checked="" type="radio"/> Turbine	Electric Motor Hand Tractor PTO
Centrifugal Rotary Flowing Well	Windmill Other (specify): _____
Other (specify): _____	Horse Power Rating of Motor: <u>60</u>
Date Pump Installed: <u>3-17-06</u>	Setting Depth: <u>70</u> feet
Rated Pump Capacity: <u>2500-3000</u> Gallons Per Minute	Number of Stages: <u>1</u>

Pump Test Data	Method of Measuring Water Level Circle one
Date Well Tested: _____	Air Line Electric Measuring Line Steel Tape
Static Water Level (A): <u>38'</u> Feet Below Land Surface	Other (specify): _____
Pumping Water Level (B): _____ Feet Below Land Surface	For flowing well, measured shut in head: _____ feet
Drawdown [(B) - (A)]: _____ Feet Below Land Surface	Well yielded _____ GPM with a drawdown of _____ feet after _____ hours of pumping
Test Pumping Rate: _____ Gallons Per Minute	
Duration of Pump Test (minimum 4 hours): _____ hours	

I HEREBY CERTIFY that the above statements are true to the best of my knowledge.

Kelly Vest

Print Name of Pump Installer and License No. (if applicable)

Kelly Vest
Signature of Pump Installer

RECEIVED

MAR 20 2006

BY: OLWR