
	tate Well Report	For Office Use Only:
County: Leflore	Part 1	
Permit #: Office	Department of Environmental Quality of Land and Water Resources	Aquifer:
Drilgation Equipment	P.O. Box 10631	Well #:
0 - 10 - 00	ackson, MS 39289-0631	L. S. Elevation:
Date drilling completed:	(601)961-5210 (601)354-6938 (fax)	F 1 #-
	(001)354-0958 (Tax)	E-log #:
State Law requires that this report be prepare	ed by the driller in detail and filed w	ith the Department within
30 days of completion of drilling of the well. Well Owner Information		Location
Owner Name Bailey McKenzie Farms	<u>5 LLC</u> Latitude:	" Longitude: 90,23,27.
Mailing Address: C/O AmSouth Bank	Method of Lat/Long (circle or	e): Conventional Survey,
Box 548	USGS quad, Hand-held	GPS, Survey-grade GPS
Greenwood MS 38930	\sim 10	
City State Zip Co		Nearest Town
662-459-2118 Telephone No.		of <u>Swiftown</u>
·	Well Data	·· ·· ·· ·· ·· ··· ··· ··· ··· ···
Purpose of Well (circle one) Home Industrial Public	Supply (Irrigation Fish Culture	Other:
Date well drilling started:	Date well drilling completed:	0=10=00
If flowing, method of flow regulation: Valve	Other (describe)	
Static Water Level: 22' feet above or below ci	rcle one) land surface Date measured:	6-13-06
\sim	ncie one) fand surface - Date measured	······
Method of Measurement (circle one) deel tape ele	ectric tape air line other:	
Hole depth: 117 Well depth: 117	Well grouted to a depth of	10 feet
Type of grout (circle one): Cement Bentonite	Mix	·····
Casing length: feet Casing diameter:		DVC Sch 10
	·· · ·	
Screen length: 40 feet Screen diameter:	<u>16</u> inches Type of screen:	PVC Sch.40
Screen slot size: . 050 inches Setting depth	n: From <u>78</u> feet to <u>11</u>	7 feet
Type of completion (circle all applicable): Gravel packed		
Type of completion (circle an applicable): Gravel packed	Underreamed Telescoped Open	hole Natural Development
Other (describe	e):	
Top of lap pipe or reduction in casingf	feet. If telescoped or more than one scre	en, describe on back of page
	mma Ray Density Sonic Neutron ()ther:
Logs run (circle all applicable): No log run Electric Gai		
Name of organization running log(s)		
Name of organization running log(s). I certify that the well was drilled, constructed, and comp	pleted in accordance with all applicable	requirements of the Mississipp
Name of organization running log(s) I certify that the well was drilled, constructed, and comp Department of Environmental Quality and/or the Missis	pleted in accordance with all applicable ssippi Department of H991th regulations	requirements of the Mississipp
Name of organization running log(s). I certify that the well was drilled, constructed, and comp	pleted in accordance with all applicable ssippi Department of H991th regulations	requirements of the Mississipp
Name of organization running log(s) I certify that the well was drilled, constructed, and comp Department of Environmental Quality and/or the Missis Irrigation Equipment Inc. Patrick M. Chism 0695	pleted in accordance with all applicable ssippi Department of Health regulations	requirements of the Mississippi and state laws.
Name of organization running log(s) I certify that the well was drilled, constructed, and comp Department of Environmental Quality and/or the Missis Irrigation Equipment Inc.	pleted in accordance with all applicable ssippi Department of Health regulations	requirements of the Mississipp and state laws.
Name of organization running log(s) I certify that the well was drilled, constructed, and comp Department of Environmental Quality and/or the Missis Irrigation Equipment Inc. Patrick M. Chism 0695	pleted in accordance with all applicable ssippi Department of Health regulations	requirements of the Mississippi and state laws.
If well telescopes please sketch below and show depths.

Ground Level

Description of Formations Encountered	From	To
Clay	0	25
Fine Sand, Fine Sand/gravel	26 36	35
Fine Sand/gravel	36	48
Med. sand/gravel	49	<u>p 1 7</u>
		╂───┨
· · · · · · · · · · · · · · · · · · ·		╞──┤
	_	
		
		┼{
		1 1
· · · · · · · · · · · · · · · · · · ·		

If more than one screen, show location of each on sketch

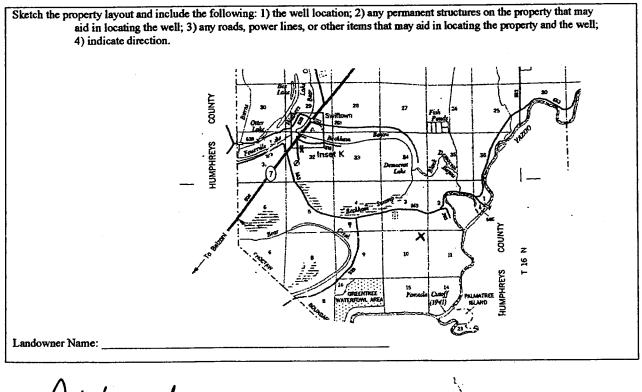

Signature of Water Well Contractor

 $\mathbb{E}_{\frac{1}{2}}$

STATE WELL REPORT				
County: Leflore Permit # <u>Construction</u> Irrigation Equipment	Pump Installer Mississippi Departme	Part 2 For Office Use Only: 's Completion Report Aquifer: and Office Resources Aquifer:		
Driller: $6-10-06$	P.O. Jackson, 1 (601	Box 10631 MS 39289-0631 J961-5210		
	Copy information from block on Part 1 (601)354-6938 (fax)			
This part of the report must be completed by a licensed water well contractor or a licensed pump installer. A copy of Part 1 of the report must be attached and both parts filed with the Department at the above address within 30 days of well completion.				
Well Owner Information Well Location				
Bailey McKenzie Owner Name:	Latitude: Longitude:			
Mailing Address: c/o AmSouth	n Bank Method of Lat/Long (check one): Conventional Survey,			
Box 548	USGS quad, Hand-held GPS, Survey-grade GPS			
Greenwood		$\underline{\text{NE}_{4}} \underline{\text{NE}_{4}} \underline{\text{Sec}} \underline{10} \underline{\text{T}} \underline{16} \underline{\text{NR}} \underline{2W}}$		
City State	City State Zip Code Distance Direction Nearest Town			
662-459-211 Telephone No. ()	8	5 Miles SE of Swiftown		
Ритр Турс		Power Type		
Circle one Air Lift let	0.1	Circle one		
· · ·	Submersible Turbine	Biesel Engine Gasoline Engine Natural Gas		
Centrifugal Rotary	Flowing Well	Electric Motor Hand Tractor PTO		
Other (specify):	-	Windmill Other (specify): Horse Power Rating of Motor:60		
6 1 2 0	6	Setting Depth:70feet		
2500-3000		Number of Stages:1		
Pump Test Data		Method of Measuring Water Level Circle one		
Date Well Tested:				
Static Water Level (A):Feet Below Land Surface				
Pumping Water Level (B):Feet Below Land Surface		Other (specify):		
Drawdown [(B) - (A)]:Feet Below Land Surface		For flowing well, measured shut in head:feet		
Test Pumping Rate:	Gallons Per Minute	Well yielded GPM with a drawdown of		
Duration of Pump Test (minimum 4 hours):	hours	feet afterhours of pumping		
I HEREBY CERTIFY that the above statem	ents are true to the best o	f my knowiedge		
Patrick M. Chism	0695	Yahil M Chin		
Print Name of Pump Installer and License N	o. (if applicable)	Signature of Pump Installer		
		Egen CCINRISME-18		
		11N 2 5 2006		
		JUN C. MF		
		Signature of Pump Installer Form: OCHARISHEED IUN 26 2006 BY: OLWE		
		₹.~.*		

•