

# State Well Report

## Part I

Mississippi Department of Environmental Quality  
Office of Land and Water Resources  
P.O. Box 10631  
Jackson, MS 39289-0631  
(601)961-5210  
(601)354-6938 (fax)

For Office Use Only:

Aquifer: \_\_\_\_\_  
Well #: P-150  
L. S. Elevation: \_\_\_\_\_  
E-log #: \_\_\_\_\_

County: Leflore  
Femitt #: GW42160  
Irrigation Equipment  
Driller: \_\_\_\_\_  
Date drilling completed: 9-24-07

State Law requires that this report be prepared by the driller in detail and filed with the Department within 30 days of completion of drilling of the well.

Well Owner Information	Well Location
Owner Name: <u>Makamson Planting</u>	Latitude: <u>33° 18' 48.0"</u> Longitude: <u>90° 25' 17.6"</u>
Mailing Address: <u>C/O Recce Makamson</u>	Method of Lat/Long (circle one): <u>48</u> Conventional Survey, <u>17</u>
<u>P.O. Box R</u>	USGS quad, Hand-held GPS, Survey-grade GPS
<u>Morgan City Ms. 38946</u>	<u>NE 1/4 NE 1/4 Sec. 29 Twn 17N Rng 2W</u>
City State Zip Code	Distance Direction Nearest Town
Telephone No. <u>(662) 455-5756</u>	<u>5</u> Miles <u>SW</u> of <u>Morgan City</u>

RECEIVED  
OCT 12 2007  
BY: OLWR

Well Data

Purpose of Well (circle one) Home Industrial Public Supply Irrigation Fish Culture Other: \_\_\_\_\_

Date well drilling started: 9-24-07 Date well drilling completed: 9-24-07

If flowing, method of flow regulation: Valve \_\_\_\_\_ Other (describe): \_\_\_\_\_

Static Water Level: 28 feet above or below (circle one) land surface Date measured: 9-24-07

Method of Measurement (circle one) steel tape electric tape air line other: \_\_\_\_\_

Hole depth: 126 Well depth: 126 Well grouted to a depth of 10 feet

Type of grout (circle one): Cement Bentonite Mix

Casing length: 86 feet Casing diameter: 16 inches Type of casing: PVC

Screen length: 40 feet Screen diameter: 16 inches Type of screen: PVC  
See Back

Screen slot size: .050 inches Setting depth: From \_\_\_\_\_ feet to \_\_\_\_\_ feet

Type of completion (circle all applicable): Gravel packed Underreamed Telescoped Open hole Natural Development

Other (describe): \_\_\_\_\_

Top of lap pipe or reduction in casing: \_\_\_\_\_ feet. If telescoped or more than one screen, describe on back of page

Logs run (circle all applicable): No log run Electric Gamma Ray Density Sonic Neutron Other: \_\_\_\_\_

Name of organization running log(s): \_\_\_\_\_


I certify that the well was drilled, constructed, and completed in accordance with all applicable requirements of the Mississippi Department of Environmental Quality and/or the Mississippi Department of Health regulations and state laws.

Irrigation Equipment Inc.  
Patrick M. Chism 0695

Print Name of Water Well Contractor and License No. \_\_\_\_\_ Signature of Water Well Contractor [Signature]

Kelly Vest contracted with us to drill well. He will set pump.



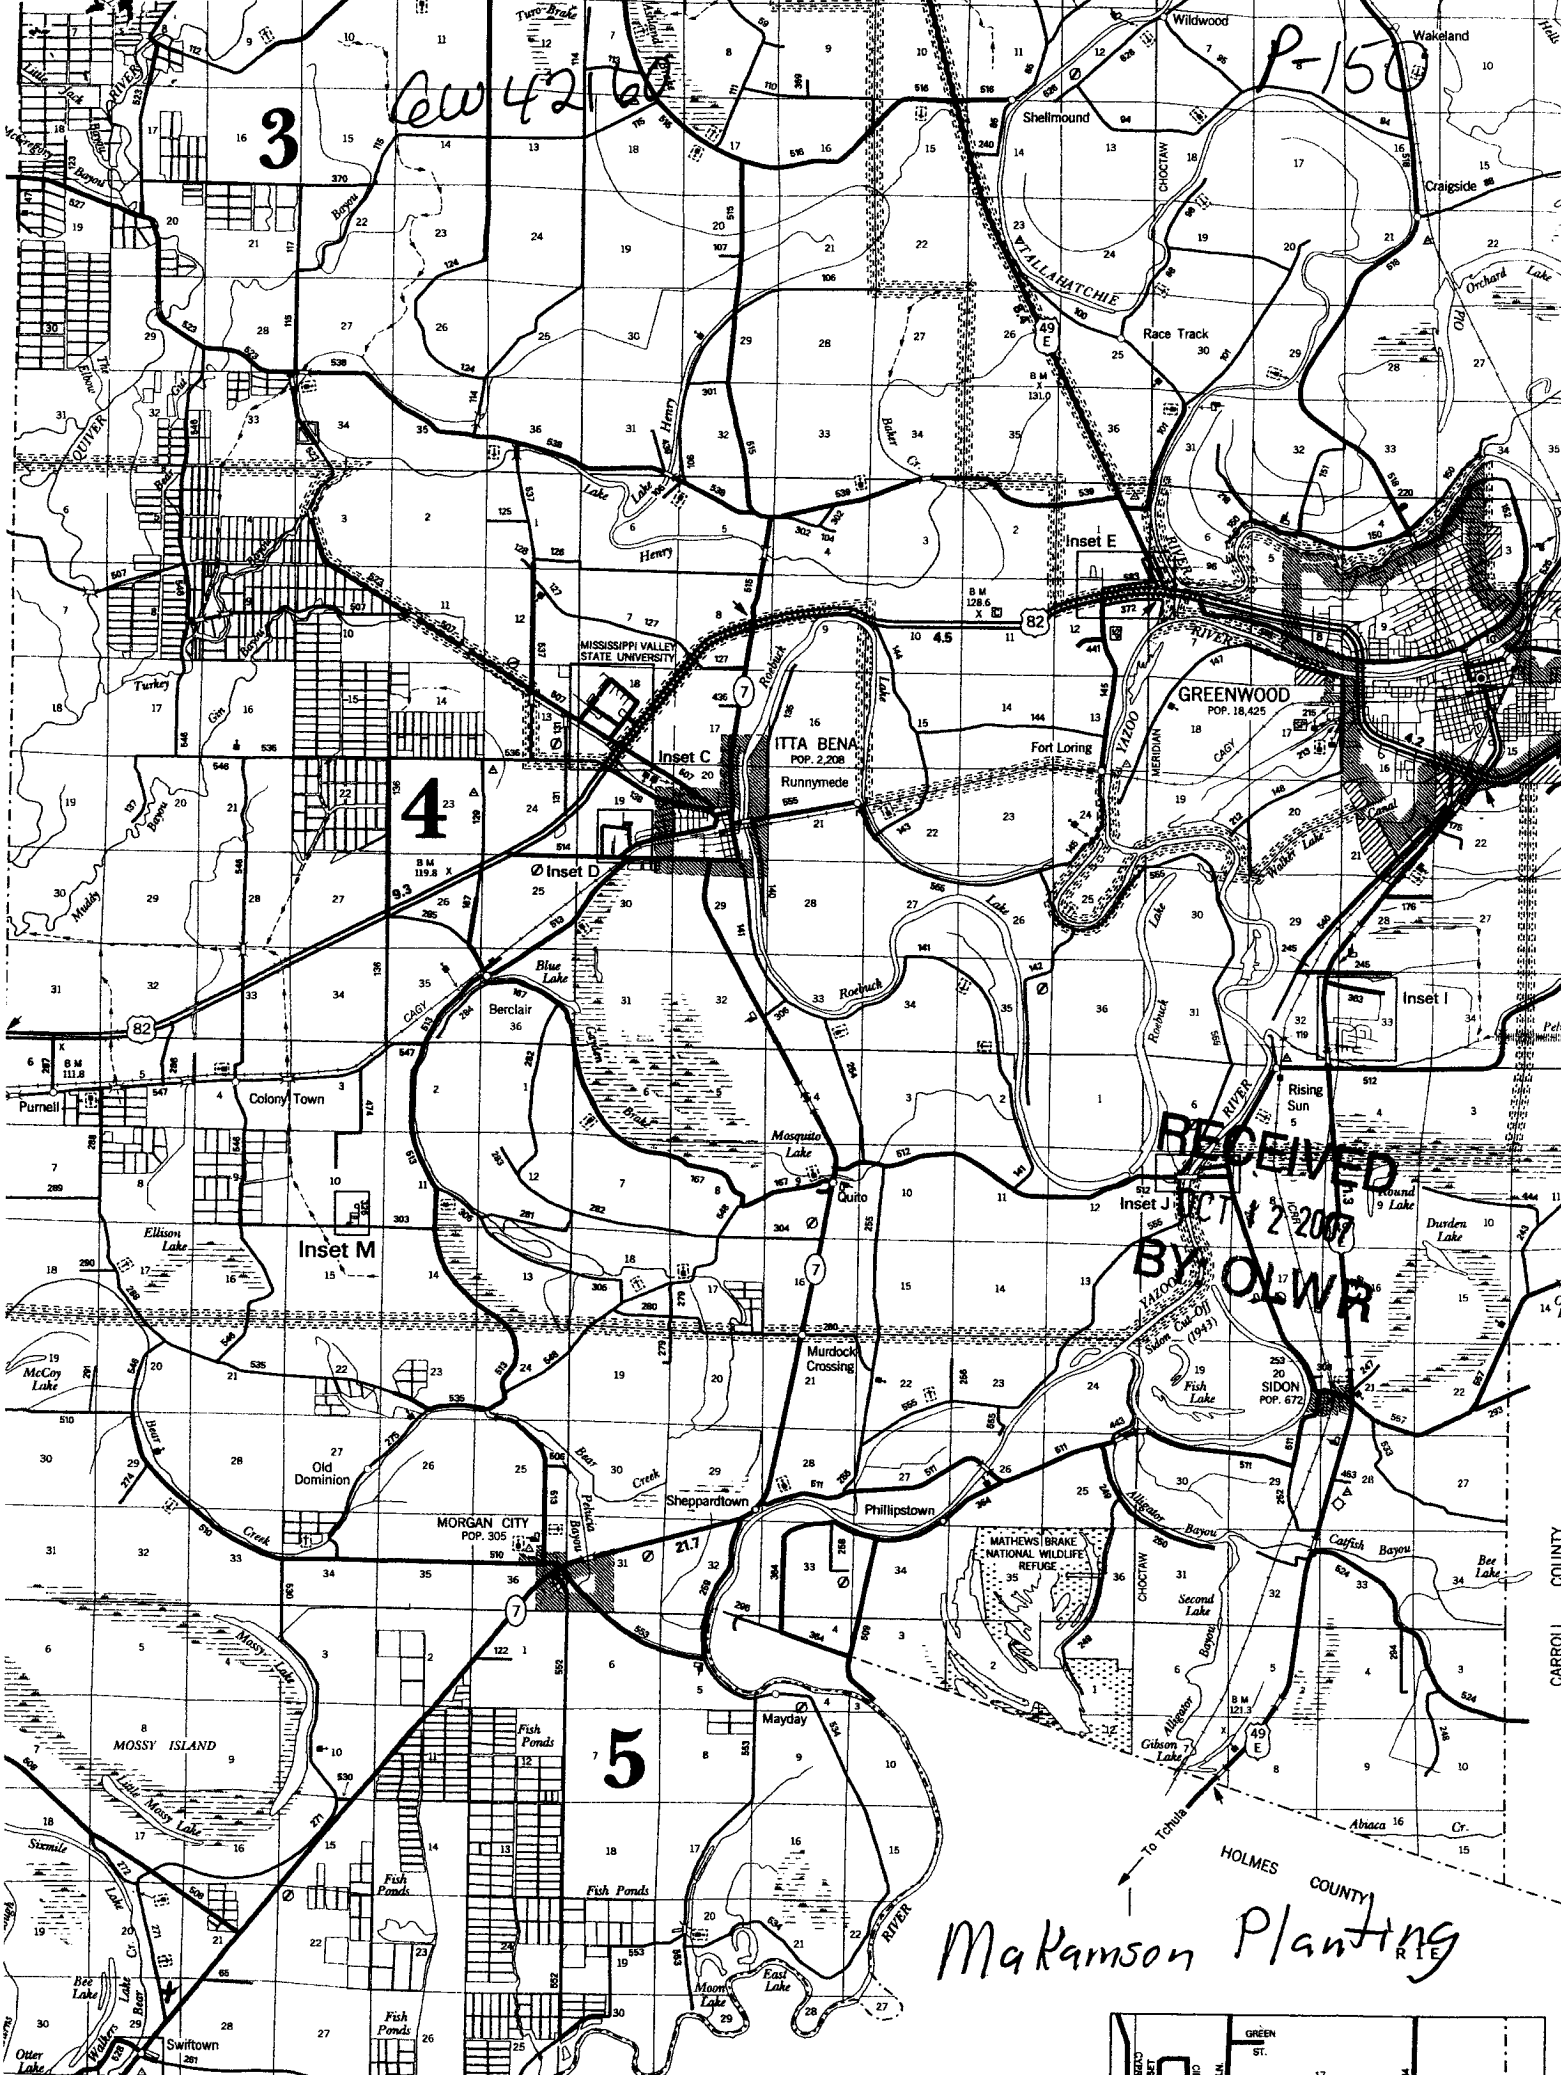

CW 42160

P-150

3

4

5

RECEIVED  
BY OLWR  
2/2007

MaKamson Planting

MISSISSIPPI VALLEY STATE UNIVERSITY

ITTA BENA  
POP. 2,208

GREENWOOD  
POP. 18,425

MORGAN CITY  
POP. 305

SIDON  
POP. 672

MATHEWS BRAKE NATIONAL WILDLIFE REFUGE

CARROLL COUNTY

HOLMES COUNTY

