

RECEIVED

JUN 27 2008

State Well Report
Part 1

Mississippi Department of Environmental Quality
Office of Land and Water Resources
P.O. Box 10631
Jackson, MS 39289-0631
(601)961-5210
(601)354-6938 (fax)

County: Leflore
Permit #: 60042605
Irrigation Equipment
Driller:
Date drilling completed: 6-19-08

For Office Use Only:
Aquifer:
Well #: P-152
L. S. Elevation:
E-log #:

State Law requires that this report be prepared by the driller in detail and filed with the Department within 30 days of completion of drilling of the well.


Well Owner Information
Owner Name: Estate of W. H. Morgan
Mailing Address: 906 Weightman St.
Greenwood Ms. 38930
City State Zip Code
Telephone No. 662 453-5612

Well Location
Latitude: 33.21 59.8 Longitude: 90.19 23.1
Method of Lat/Long (circle one): Conventional Survey
USGS quad, Hand-held GPS, Survey-grade GPS
NE 1/4 SW 1/4 Sec 5 Twn 17N Rng 1W
Distance Direction Nearest Town
2 Miles SE of Morgan City

Well Data
Purpose of Well (circle one) Home Industrial Public Supply Irrigation Fish Culture Other:
Date well drilling started: 6-19-08 Date well drilling completed: 6-19-08
If flowing, method of flow regulation: Valve Other (describe):
Static Water Level: 25 feet above of below (circle one) land surface Date measured: 6-19-08
Method of Measurement (circle one) steel tape electric tape air line other:
Hole depth: 127 Well depth: 127 Well grouted to a depth of 10 feet
Type of grout (circle one): Cement Bentonite Mix
Casing length: 87 feet Casing diameter: 16 inches Type of casing: PVC
Screen length: 40 feet Screen diameter: 16 inches Type of screen: PVC
Screen slot size: .050 inches Setting depth: From 88 feet to 127 feet
Type of completion (circle all applicable): Gravel packed Underreamed Telescoped Open hole Natural Development
Other (describe):
Top of lap pipe or reduction in casing: feet. If telescoped or more than one screen, describe on back of page
Logs run (circle all applicable): No log run Electric Gamma Ray Density Sonic Neutron Other:

Name of organization running log(s):
I certify that the well was drilled, constructed, and completed in accordance with all applicable requirements of the Mississippi Department of Environmental Quality and/or the Mississippi Department of Health regulations and state laws.
Irrigation Equipment Inc
Patrick M. Chism 0695
Print Name of Water Well Contractor and License No. Signature of Water Well Contractor

Kelly Vest contracted with us to drill well.
He will set pump.

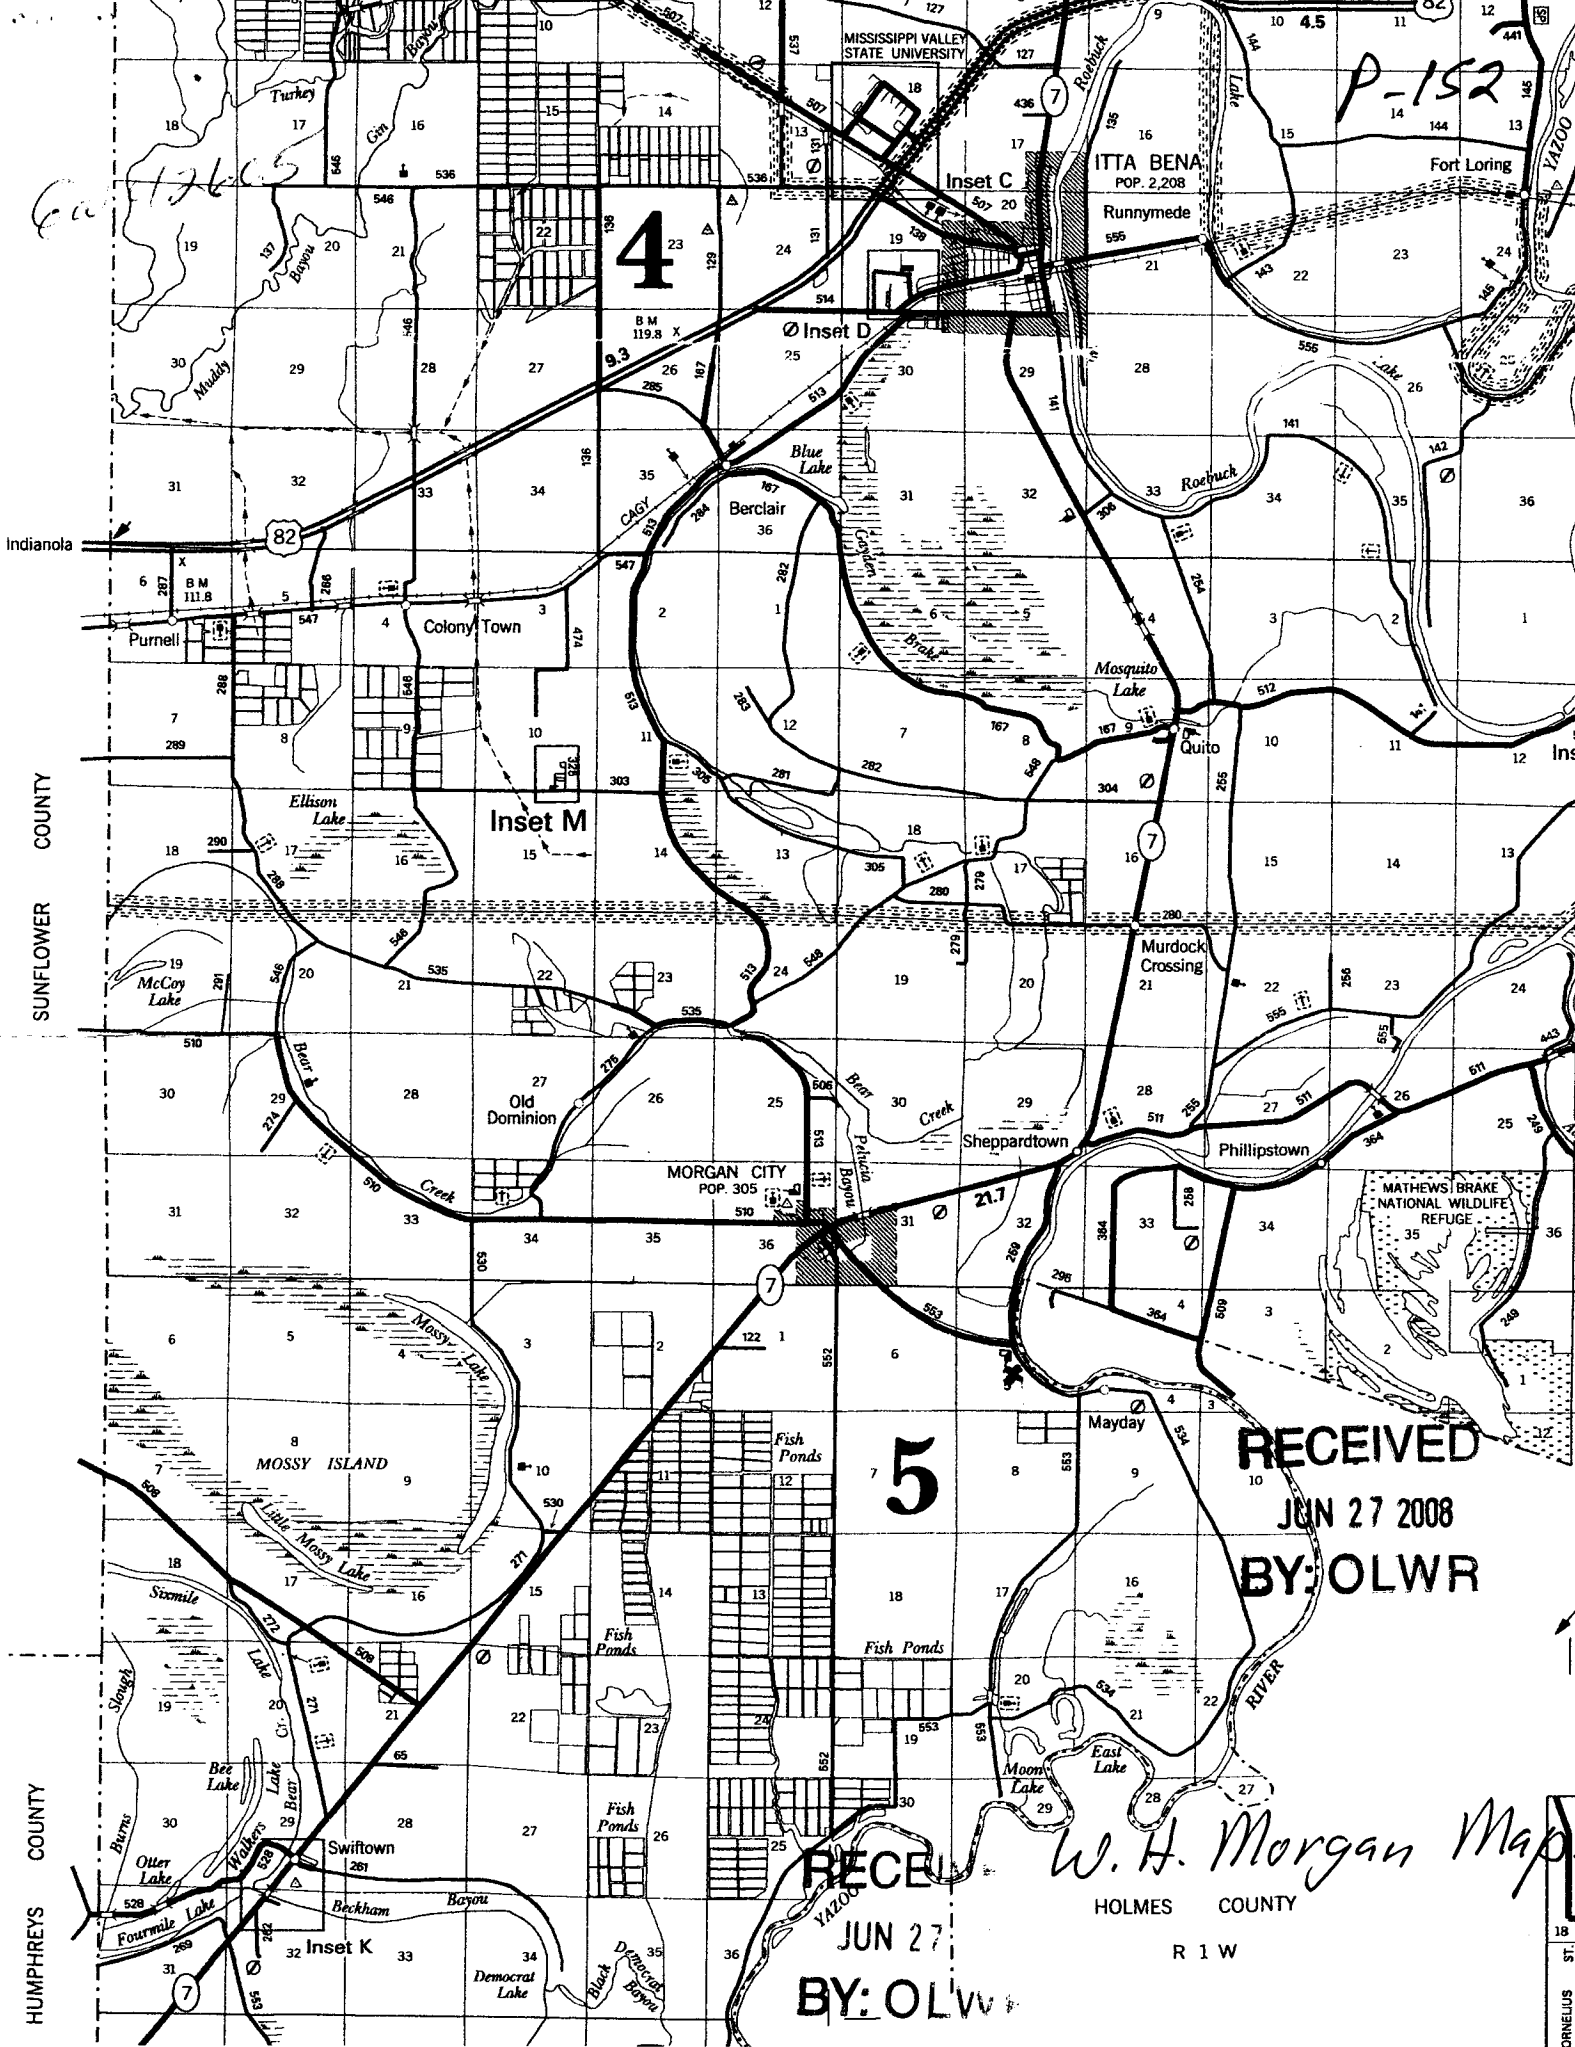

P-152

4

5

RECEIVED
JUN 27 2008
BY: OLWR

W. H. Morgan Map

RECEIVED
JUN 27
BY: OLWR

HOLMES COUNTY

R 1 W

SUNFLOWER COUNTY

HUMPHREYS COUNTY

Indianola

ORNELIUS ST.