

State Well Report

Part 1 - Driller's Log

Mississippi Department of Environmental Quality
Office of Land and Water Resources
P.O. Box 2309
Jackson, MS 39225
(601)961- 5210
(601)961- 5228 (fax)

County: Leflore
Permit #: GW-44577
Irrigation Equipment
Driller: _____
Date drilling completed: 10-30-10

For Office Use Only:
Aquifer: P 162
Well #: _____
L. S. Elevation: _____
E-log #: _____


State Law requires that this report be prepared by the license holder responsible for the work and filed with the Department at the above address within 30 days of completion of drilling of the well or borehole.

<p align="center">Information on Well Owner <i>(Landowner if borehole is not for a water well)</i></p> <p>Owner Name: <u>Dwight Dunn</u> Mailing Address: <u>9337 County Rd 142</u> <u>Itta Bena Ms. 38941</u> City State Zip Code Telephone No. () _____</p>	<p align="center">Well or Borehole Location</p> <p>Latitude: <u>33-21-07.5</u> Longitude: <u>90-18-31.0</u> Method of Lat/Long (circle one): Conventional Survey, USGS quad, Hand-held GPS, Survey-grade GPS <u>SE 1/4 NW 1/4 Sec 9 Twn 17N Rng 1W</u> Distance Direction Nearest Town <u>3</u> Miles <u>SE</u> of <u>Morgan City</u></p>
---	--

Well / Borehole Data

Date drilling started: 10-30-10 Date drilling completed: 10-30-10 Hole depth: 124 Hole diameter: 24"
Location of the source of any surface water used for drilling: Surface Water
Method of dosing and volume of Chlorine used in drilling and development: 50 PPM
Logs run (circle all applicable): No log run Electric Gamma Ray Density Sonic Neutron Other: _____
Name of organization running log(s): _____
Purpose of borehole (check one): Water Well Geotechnical/Geological Investigation _____ Ground Source Heat Pump _____
Seismic Survey _____ Other (describe) _____
If drilling is not related to water well construction, skip the remainder of this block

Purpose of Well (check one): Home _____ Industrial _____ Public Supply _____ Irrigation Fish Culture _____ Other: _____
If a flowing well, method of flow regulation: Valve _____ Other (describe) _____
Static Water Level: 23 feet above of below (circle one) land surface Date measured: _____
Method of Measurement (circle one) steel tape electric tape air line other: _____
Well depth: 124 Well grouted to a depth of 10 feet Type of grout (circle one): Neat Cement Bentonite Mix
Casing length: 84 feet Casing diameter: 16 inches Type of casing: PVC
Screen length: 40 feet Screen diameter: 16 inches Type of screen: PVC
Screen slot size: .050 inches Setting depth: From 85 feet to 124 feet
Type of completion (circle all applicable): Gravel packed Underreamed Telescoped Open hole Natural Development
Other (describe): _____
Top of lap pipe or reduction in casing: _____ feet. *If telescoped or more than one screen, describe on next page*

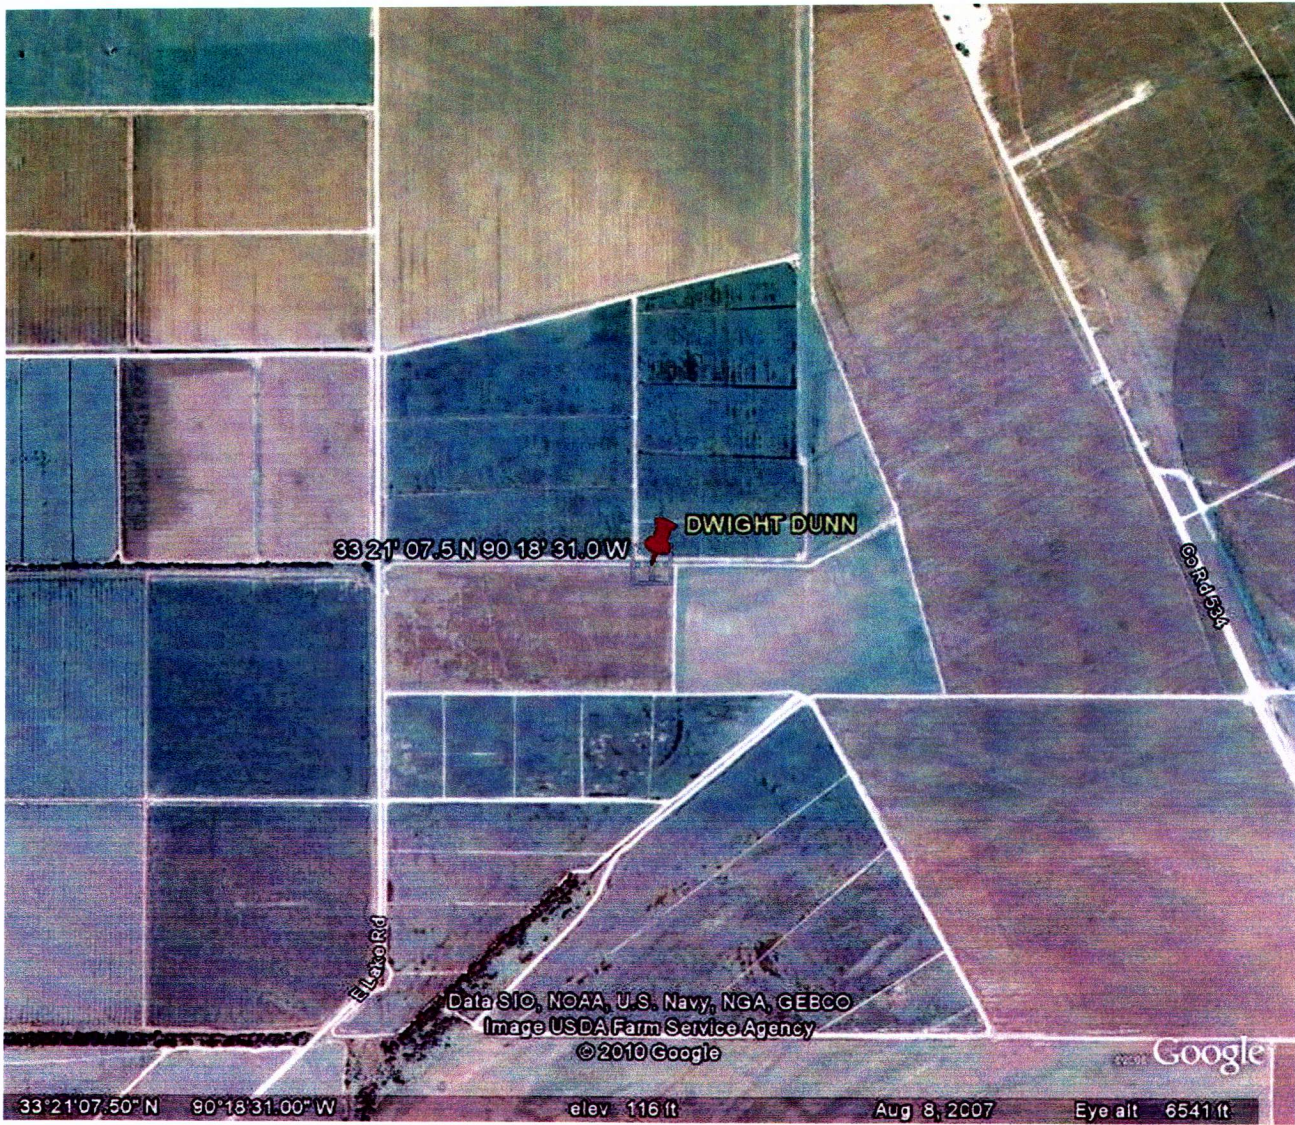

RECEIVED
NOV 04 2010
BY: OLWR