

Leftore
P 1002

MISSISSIPPI BOARD OF WATER COMMISSIONERS

2-66

WATER WELL DRILLERS LOG

BATTAM GAS CO

Date: 2-16, 1966, Driller: OF GREENWOOD County LEFTORE

(Name)

(1) Owner of Land: MACR, KIMBERGEM
(Name)
MORGAN CITY, MISS
(Address)

(2) Location: 4 SO. MORGAN CITY
(distance) (direction) (Nearest Town)

(3) Topography: FLAT
(Hilly) (Flat) (Level)

(4) Purpose of Well: IRRIGATION
(Domestic Irrigation
Municipal, Industrial, Other)

Description & Color of Materials Sand, Clay, Red Clay, Shell, etc.	Thick- ness Feet	Depth Feet
<u>0-13 TOPSOIL</u>	<u>13</u>	<u>13</u>
<u>23 GUMBI</u>	<u>10</u>	<u>23</u>
<u>33 PROWN CLAY</u>	<u>10</u>	<u>33</u>
<u>43 BLUE CLAY</u>	<u>10</u>	<u>43</u>
<u>53 SAND</u>	<u>10</u>	<u>53</u>
<u>63 COARSE SAND + GRAVEL</u>	<u>10</u>	<u>63</u>
<u>73 GRAVEL</u>	<u>10</u>	<u>73</u>
<u>115 GRAVEL</u>	<u>42</u>	<u>115</u>

BATTAM 111'

Information upon completion of well:

- (1) Diameter 16 inches.
- (2) Total Depth 111 feet.
- (3) Water Level 15' feet below top of ground.
- (4) Cased to 71', Size 16"
- (5) Screen: Size 16", Length 40'
- (6) Were any formations sealed against pollution?
 yes, no.


If YES depth of formation _____
Why _____

Drillers Remarks: _____

Yield in G. P. M.: 1600 GPM

Type power: ELECTRIC

Crops irrigated & Acreage: RICE 77

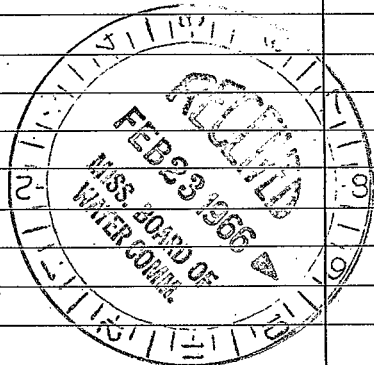

(Use Back Side)

Well No.

