

MISSISSIPPI DEPARTMENT OF NATURAL RESOURCES

Bureau of Land and Water Resources

Southport Mall

P.O. Box 10631

Jackson, Mississippi 39209

WATER WELL DRILLERS LOG

LEFLORE
P 2000
12/12/80

12/12 1980
date well completed

Larry's Well & Pump
firm name

Leflore
county well located

LANDOWNER: E.A. Maxey

description of formations encountered

from

to

Swiftown, MS
(mailing address)

WELL LOCATION:

sec. 5 T. 16 N. R. 2 W.
2 miles SE of Swiftown
(distance) (direction) (nearest town)

WELL PURPOSE:

(home, irrigation, municipal, industrial)

WELL COMPLETION DATA: 100' - 4"


- (1) diameter (inches) 4" x 2"
- (2) total depth (feet) 460
- (3) static water level (feet) 20 below above top of ground.
- (4) casing plastic, 420'
(material) (depth)
(size) if telescope see back.
- (5) screen 40 420
(length) (depth to top)
2 plastic
(size) (material)
- (6) pump 1/2 10
(HP) (yield gpm)
(type power)
- (7) electric log N/O
(yes or no)

(organization running log)

(8) how well bottom plugged _____


DRILLERS REMARKS: _____

description of formations encountered	from	to
<u>clay</u>	<u>0</u>	<u>20</u>
<u>fine sand</u>	<u>20</u>	<u>40</u>
<u>med sand</u>	<u>40</u>	<u>60</u>
<u>some sand + gravel</u>	<u>60</u>	<u>120</u>
<u>clay</u>	<u>120</u>	<u>200</u>
<u>sand & clay streaks</u>	<u>200</u>	<u>205</u>
<u>sand</u>	<u>400</u>	<u>460</u>

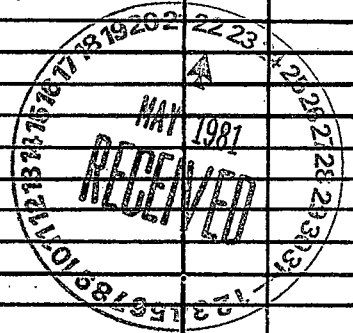

If well telescopes please sketch and show depths.

GROUND LEVEL

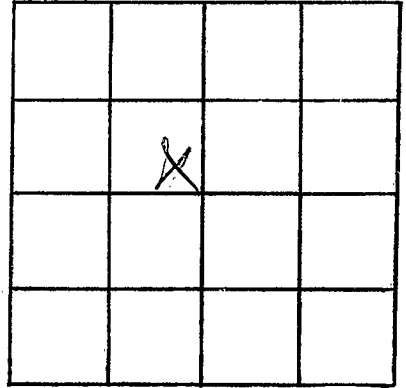

SECTION 5

Please indicate well location X.

ADDITIONAL INFORMATION

If more than one screen,
show locations of each on sketch.